

Name P. J. Shanahan

Service No. ~~88~~ 2249

Address 52 Pleasant Street

Location 52 Pleasant St.,

Kind of Pipe

Size

Size of Main

~~Repair~~—Renewal—~~New Service~~

Location

Date	Material	Amount	Total	Date	Amount
5/17/40	1½ hrs. @ 60¢	90		July 20, 1940 Paid	21 96
<i>Com 6/11/40</i>	1½ " @ 65¢	98	1 88		
	10% Overhead		18		
	65' 1" Copper tubing @ 21¢		13 65		
	1 1" C x 3/4" I.S.& W.		2 25		
	1 1" C. Union (3 parts)		1 00		
	Trucking, 4 hrs. @ 75¢		3 00		
			21 96	<i>Bill sent 5/29/40</i>	
	Labor				

Hadley Press, Inc., Lexington

# TOWN OF LEXINGTON—BOARD OF PUBLIC WORKS

## WATER DIVISION

The undersigned applies for a supply of water at No. \_\_\_\_\_ St. and hereby agrees to comply with the rules and regulations as now, or at any future time, established by the Board of Selectmen.

Am't. of Estimate \$ \_\_\_\_\_


Owner \_\_\_\_\_

Am't. Paid \$ \_\_\_\_\_

Address \_\_\_\_\_

Builder \_\_\_\_\_

Sketch of Service Here

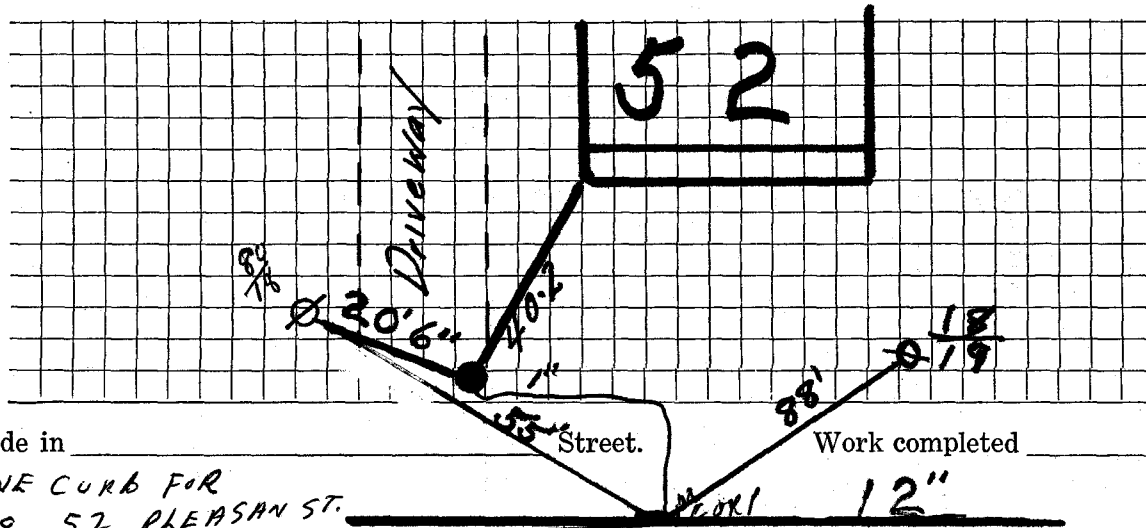

Connection made in \_\_\_\_\_

Street.

Work completed \_\_\_\_\_

19

Remarks: ONE CURB FOR  
48 - 52 PLEASANT ST.

12"