

Name

1431

Service No. 2250

Address 53 Pleasant St.

Location 53 Pleasant St.

Kind of Pipe

Size

Size of Main

Repair—Renewal—New Service

Location

Date

Material

Amount

Total

Date

Amount

Labor

TOWN OF LEXINGTON—BOARD OF PUBLIC WORKS

WATER DIVISION

The undersigned applies for a supply of water at No. _____ St. and hereby agrees to comply with the rules and regulations as now, or at any future time, established by the Board of Selectmen.

Am't. of Estimate \$ _____

Owner

Emily Saul


Am't. Paid \$ _____

Address

53 Pleasant St.

Builder _____

Sketch of Service Here

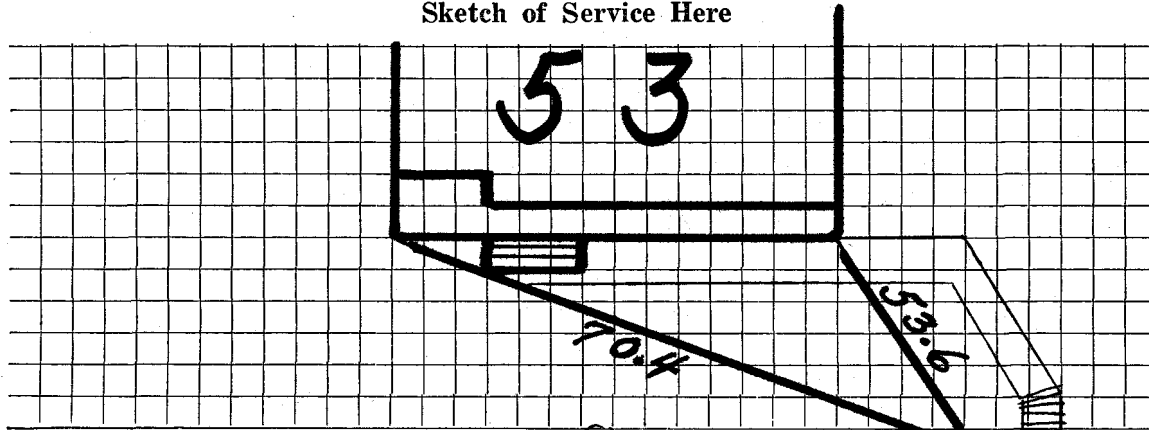

Connection made in _____

Street.

38.5

Work completed

19

Remarks:

curb

6'-6"