

## WATER SERVICE RECORD

Name

Service No.

Address

57 Pleasant St.

Location

Repair—Renewal—New Service

✓ J.M. Lucente # 2372


Date		Material	Amount		Total		Date		Amount	
11-14-	73	160' - 1" Copper					11-1-	73		
									18'	1" Copper
									1	1" Curb Cock
									1	1" Corp Cock
									1	Box + Rod

DATE \_\_\_\_\_

# TOWN OF LEXINGTON — BOARD OF PUBLIC WORKS

## WATER DIVISION

Sketch of Service Here

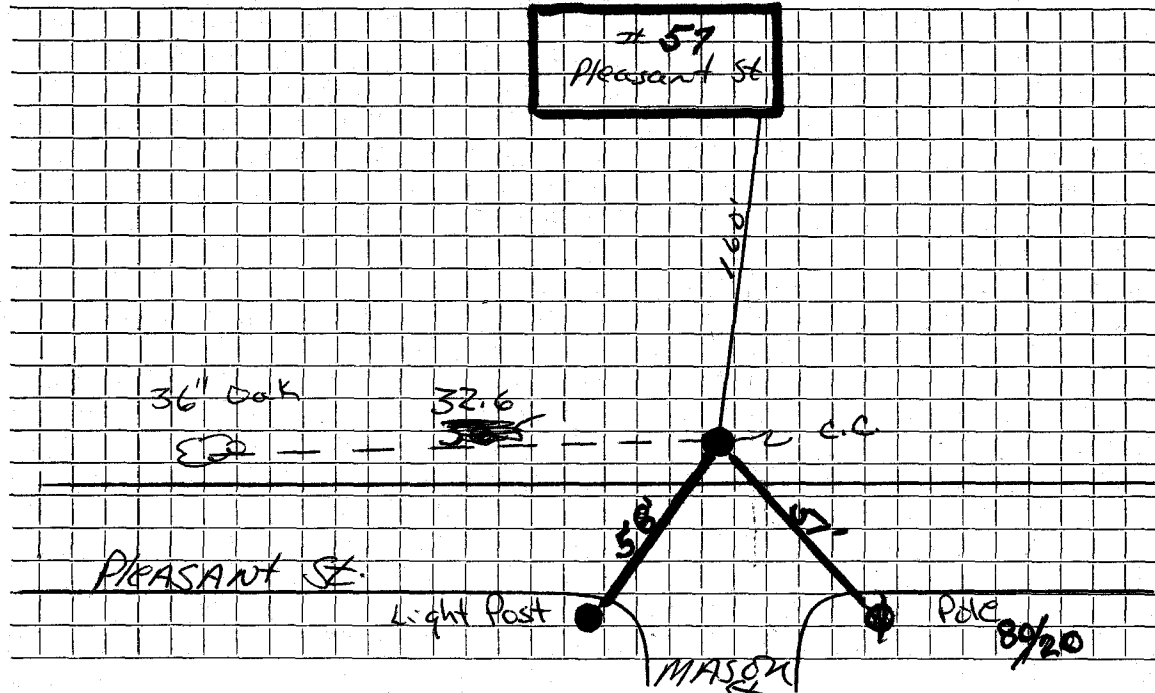

Connection made in ..... Street.

Remarks: .....

.....

.....