

Name Francis Walsh

Service No. 208

Address 60 Pleasant Street

Lexington, Mass.

Location 60 Pleasant Street

Kind of Pipe

Size

Size of Main

~~Repair~~ Renewal ~~New Service~~

Com. 12-13-19

Location

Date	Material	Amount	Total	Date	Amount
Oct. 17, '49	Labor	22 34	22 34	Oct 5, '49	50 00
	10% Overhead		2 23	Dec 22 '49	1 28
	78' - 3/4" Copper Tubing @.24	18 72			48 72
	1 - 3/4"C x 1/2" I.W.H. S&W	3 29			
	1 - 3/4"C x 3/4" C Union (3pts)	1 39		Oct. 17, '49	19 00
	Trucking 1 hr. @.75		75	1 - 3/4"C x 3/4" I Union (2pts)	1 01
			48 72	1 - 1/2" Offset Tail Piece	37
				Trucking 1 hr. @.75	75
	Relocate Service from 6" to 12" Main				21 13
6/30/51	21' 3/4" Copper tubing				
	1 3/4" Corp.				
	1 3/4" Curb				
	20' x 14' Patch				
	Labor				

DATE _____

TOWN OF LEXINGTON – BOARD OF PUBLIC WORKS

WATER DIVISION

The undersigned applies for a supply of water at No..... St. and hereby agrees to comply with the rules and regulations as now, or at any future time, established by the Board of Selectmen.

Am't of Estimate \$.....

Owner


Am't Paid \$.....

Address

Builder

.....

Sketch of Service Here

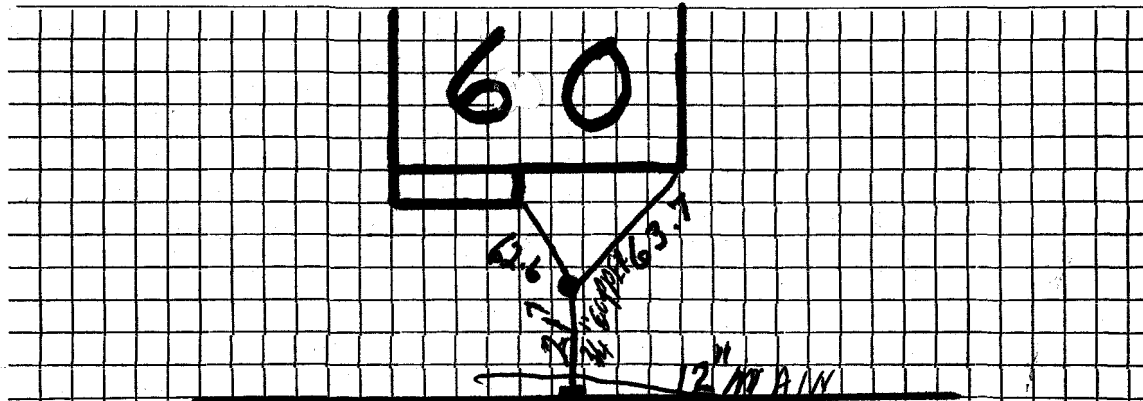

Connection made in Street.

Work completed19

Remarks: