

WATER SERVICE RECORD

Name Ben Franklin Homes

Service No. 51

Address 60

4560 # 7279

Location 64 Pleasant St.

DEC 31 1970

~~Repair - Renewal - New Service~~ W.O. # 9082 Sibley # 1754


Date	Material	Amount	Total	Date	Amount
10/27/70	Labor	107 60		10-16-70	425 00
	Officer	40 00		1-18-71	77 10
11/4/70	Labor	25 09			347 90
11/6/70	"	21 72			
	16" O.H.	19 44	213 85		
39'	3/4" Copper pipe	.79	30 81		
	3/4" Corporation		9 57		
	3/4" Curb stop		11 32		
	Box & Rd		5 10		
3 1/2	Ton Hot top	6.00	21 00		
5 1/2	Hrs. Trucking	3.00	16 50		
1 1/2	"	1.50	2 25		
4	" Shovel	6.50	26 00		
1	" Compressor		5 00		
1 1/2	" Loader	5.00	2 50		
1	" Roller		2 00		
	Trailer		2 00		
			<u>347 90</u>		
10-24-70	105' 3/4" Copper tubing				

DATE _____

TOWN OF LEXINGTON — BOARD OF PUBLIC WORKS

WATER DIVISION

Sketch of Service Here

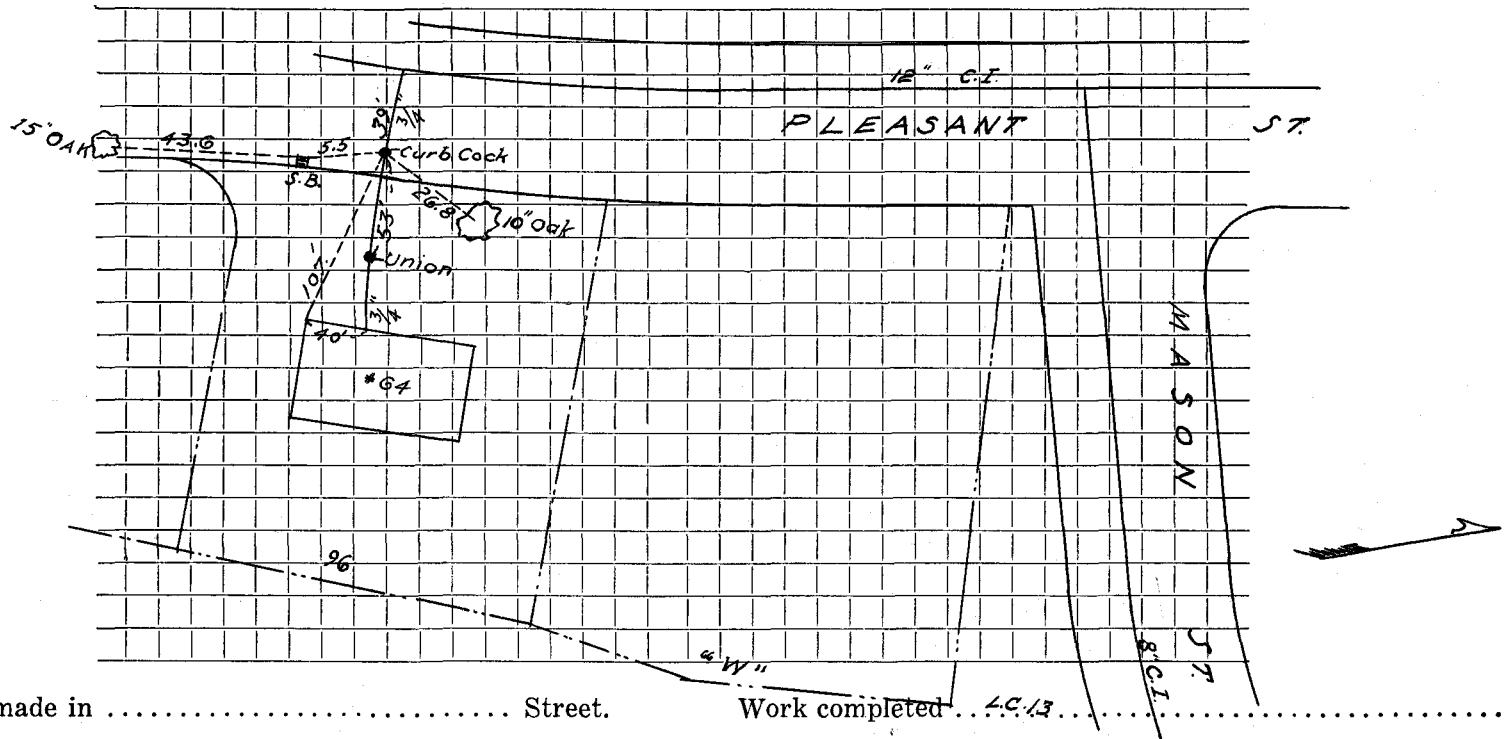

Connection made in Street. Work completed

Remarks:

.....

.....