

Name Gustave LarsonService No. 20Address 66 Pleasant StreetLexington, Mass.Location 66 Pleasant Street

Kind of Pipe

Size

Size of Main

~~Repair~~ ~~Renewal~~ New ServiceCom. June 7, 1948

Location

Date	Material	Amount	Total	Date	Amount
Apr. 9, '48	Labor	4 75		April 6, '48	25 00
10	"	<u>1 05</u>	5 80	June 10, '48	4 41
	10% Overhead		58		70 67
	47' - 3/4" Copper Tubing @	255 11 99		Apr. 10, '48	6 12
	1 - 3/4" C x 1/8" I.W.H. S & W	3 15		36' - 3/4" Copper Tubing @.255	9 18
	1 - 3/4" C x 3/4" C Union (3pts)	1 32		1 - 3/4" C Corp-cock	3 00
	Littlefield Shovel 2 hrs. @	7.00	14 00	1 - 3/4" C x 3/4" C Curb-cock	3 68
	Patching 33 x 3		33 00	1 - 3/4" C x 3/4" C Union (3pts)	1 32
	Trucking 1 hr. @.75		<u>75</u>	1 - Box & Rod	3 50
			70 59	1 - 1/2" Offset Tail Piece	30
				1 - 1/2" Straight Tail Piece	30
				Trucking 1 hr. @.75	75
				Littlefield Shovel 2 hrs. @.75	14 00
	Labor			7-26-71	42 15
				13' 3/4" Copper	
				1 3/4" Corp Cock	
				1 3/4" - 3 Part Union	

TOWN OF LEXINGTON - BOARD OF PUBLIC WORKS

WATER DIVISION

The undersigned applies for a supply of water at No..... St. and hereby agrees to comply with the rules and regulations as now, or at any future time, established by the Board of Selectmen.

Am't of Estimate \$.....

Owner


Am't Paid \$.....

Address

Builder

.....

Sketch of Service Here

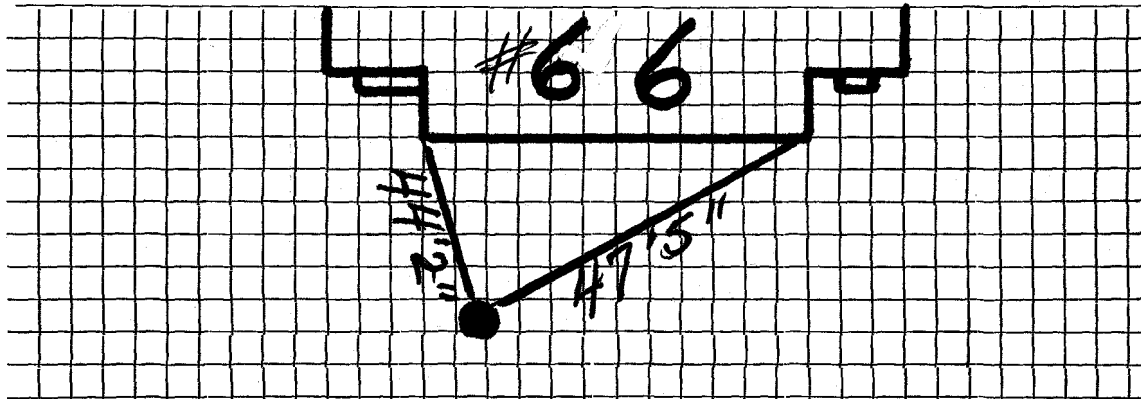

Connection made in Street.

Work completed19

Remarks: