


DATE _____

TOWN OF LEXINGTON — BOARD OF PUBLIC WORKS WATER DIVISION

Sketch of Service Here

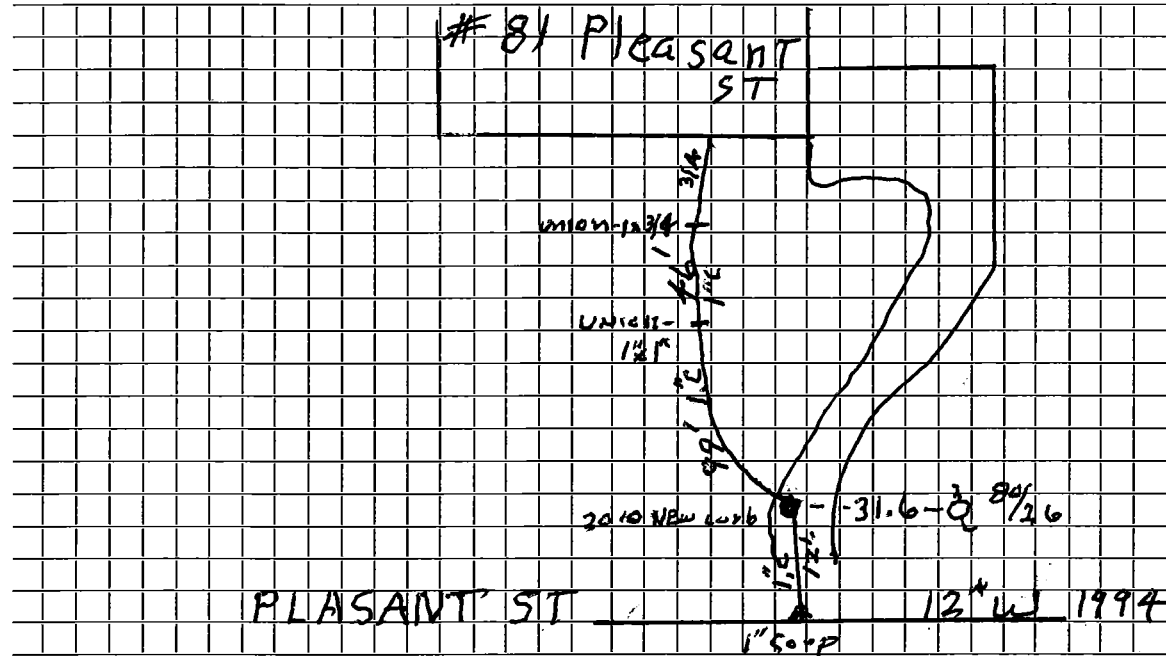

Connection made in Street. Work completed Deflice-Water Main

Remarks: Total 1" Copper - 145'

.....

.....