

### WATER SERVICE RECORD

Name Mrs Mimno

Service No.

Address 83 Pleasant Street

Location

~~Repair~~—Renewal—~~New Service~~ D & F Trucking #3581


Date	Material	Amount	Total	Date		Amount
6/13/80	200' 1" Copper tubing					
					OUTSIDE	
				6/19/80	Labor	
					12'6" 1" Copper tubing	
					1 1" Corp	
					1 1" Curb	
					1 Box & Rod	
					3 hrs. Trucking	
					3 hrs. Town Shovel	
					Patch 9' x 10'	

DATE \_\_\_\_\_

# TOWN OF LEXINGTON — BOARD OF PUBLIC WORKS

## WATER DIVISION

Sketch of Service Here

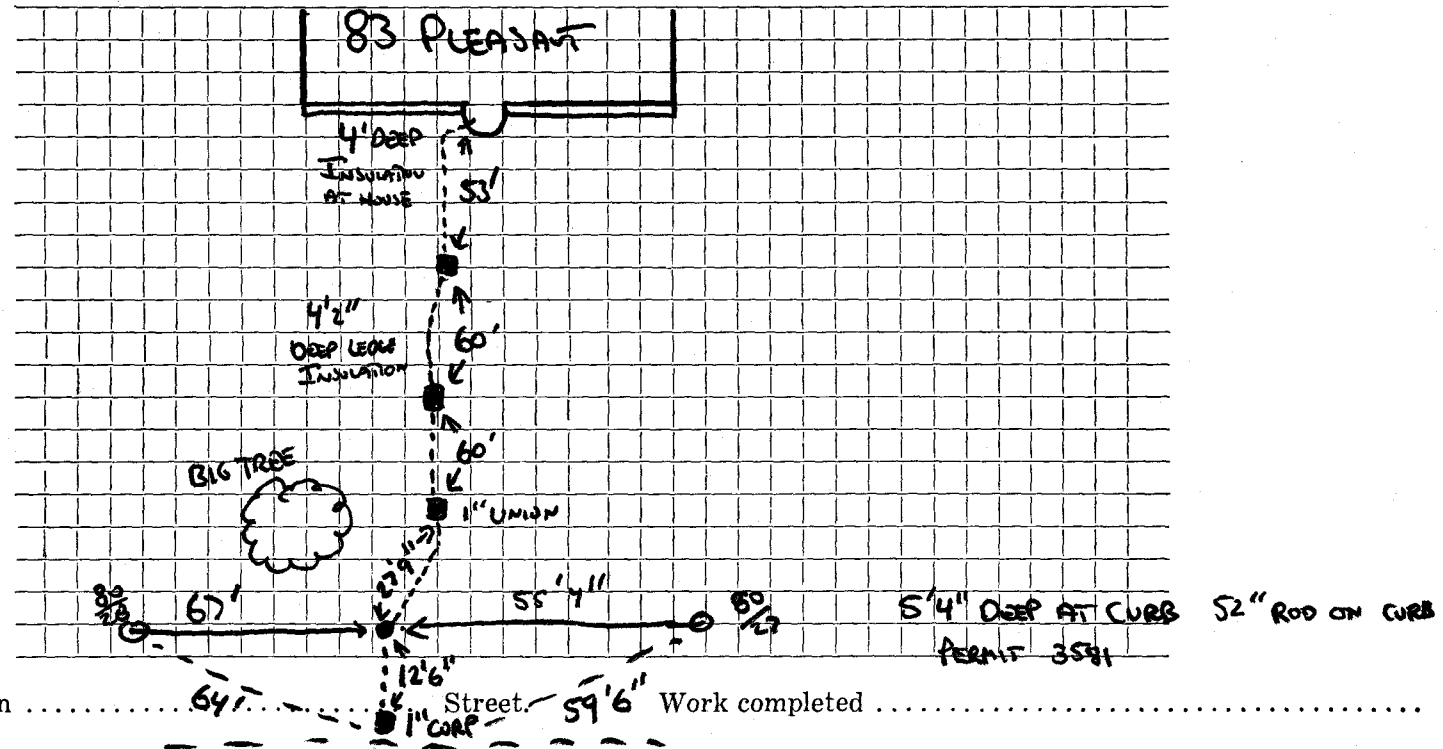

Connection made in ..... 64' ..... Street ..... 59' 6" Work completed .....

Remarks: .....

.....

.....