


DATE _____

TOWN OF LEXINGTON — BOARD OF PUBLIC WORKS

WATER DIVISION

Sketch of Service Here

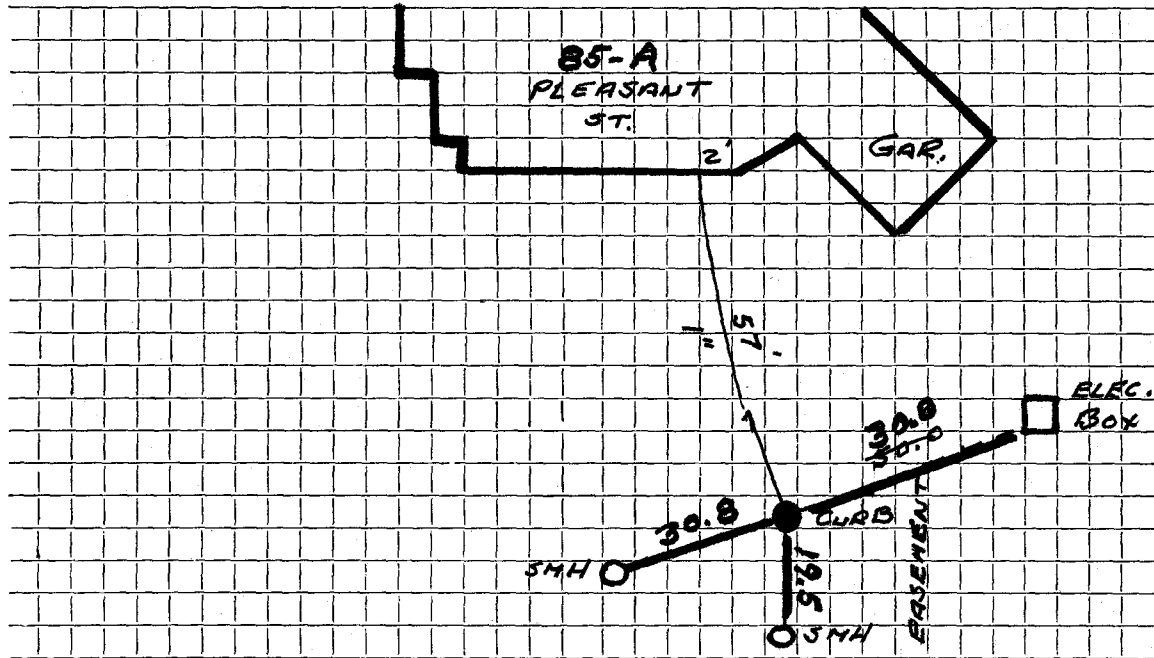

Connection made in EASEMENT Street. Work completed

Remarks: J. McLAUGHLIN CONTR.