

WATER SERVICE RECORD

Name

Service No.

Address #93 Pleasant St. Was

OLD H66.
(91 Pleasant.)

Location

Repair—Renewal—New Service


Date	Material	Amount	Total	Date	Amount
Apr. 25, 1950	① 1" corp. ① 1/2" bolt ① 3/4 offset ① 3/4 straight tail piece 12' of 1" copper.				
May 1 1950	245-ft. 1" copper. ① 1"x1" s&w ④ 1" unions ① 1"x3" bushings				
7/58	① dc 1" bolt 69 ft 1" copper				

TOWN OF LEXINGTON — BOARD OF PUBLIC WORKS

WATER DIVISION

Sketch of Service Here

old house #91 Pleasant disconnected to the old service, & reconnected to Dover Lane

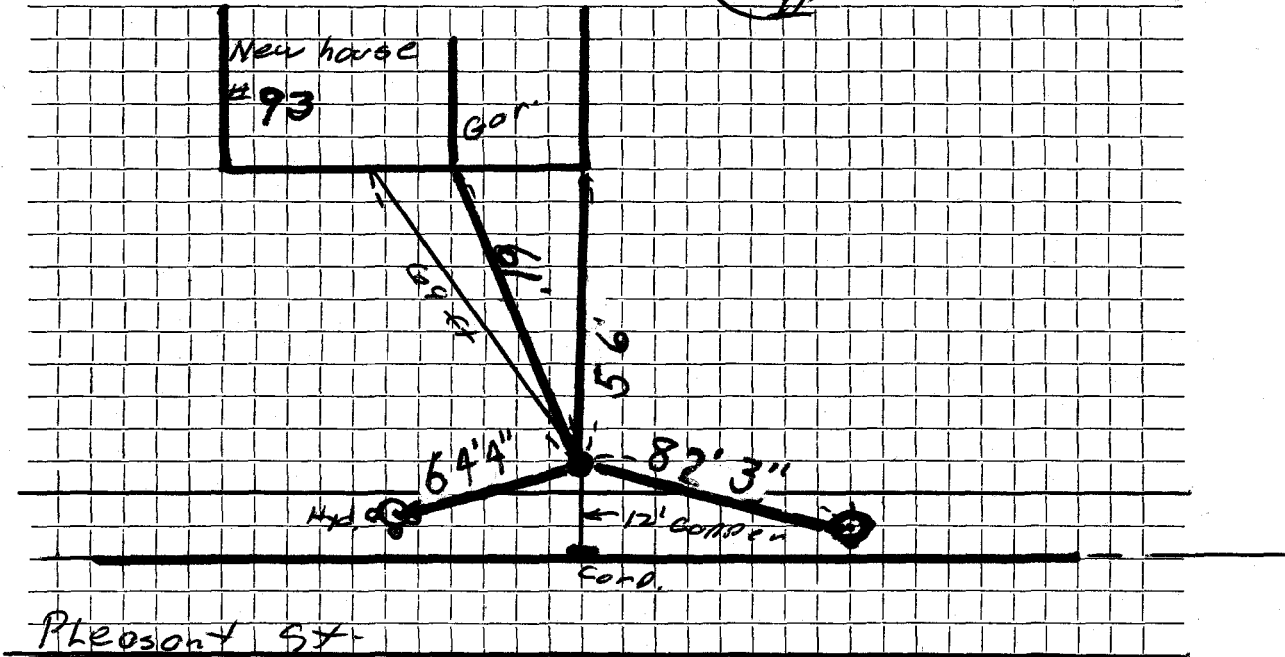

Connection made in Street. Work completed

Remarks:
.....
.....