

Name Frank M. Carpenter

Service No. 80

Address 94 Pleasant Street  
Lexington, Mass.

Location 94 Pleasant Street

Kind of Pipe

Size

Size of Main

~~Repair~~ ~~Renewal~~ — New Service

Com. 8-23-48

Location

Date	Material	Amount	Total	Date	Amount
Jul. 9, '48	Labor	6 40	6 40	June 24 '48	75 00
	10% Overhead		64	Aug 20 '48	11 43
	62' - 3/4" Copper Tubing @.255	15 81			67 57
	1 - 3/4" C x 1/2" I.W.H. S & W	3 15			
	1 - 3/4" C x 3/4" C Union (3pts)	1 32		Jul. 9, '48	Labor
	Littlefield Shovel 2 1/2 hrs. @ 7.00	17 50			22 40
	Trucking 1 hr. @.75	75		25' - 3/4" Copper Tubing @.255	6 38
	Patching 18 x 3	18 00		1 - 3/4" C Corp-cock	3 00
		63 57		1 - 3/4" C x 3/4" C Curb-cock	3 68
				1 - Box & Rod	3 55
				1 - 1/2" Offset Tail Piece	30
				1 - 1/2" Straight Tail Piece	30
				Shovel 4 hrs. @ 7.00	28 00
				Trucking 1 hr. @.75	75
	<b>Labor</b>				<u>68 36</u>

*Deposited*  
*Refunded*  
Non-Charge

Hadley Press, Inc., Lexington

DATE \_\_\_\_\_

# TOWN OF LEXINGTON—BOARD OF PUBLIC WORKS

## WATER DIVISION

The undersigned applies for a supply of water at No. \_\_\_\_\_ St. and hereby agrees to comply with the rules and regulations as now, or at any future time, established by the Board of Selectmen.

Am't. of Estimate \$ \_\_\_\_\_

Owner \_\_\_\_\_


Am't. Paid \$ \_\_\_\_\_

Address \_\_\_\_\_

Builder \_\_\_\_\_

*23 Birch Rd. Jay*

Sketch of Service Here

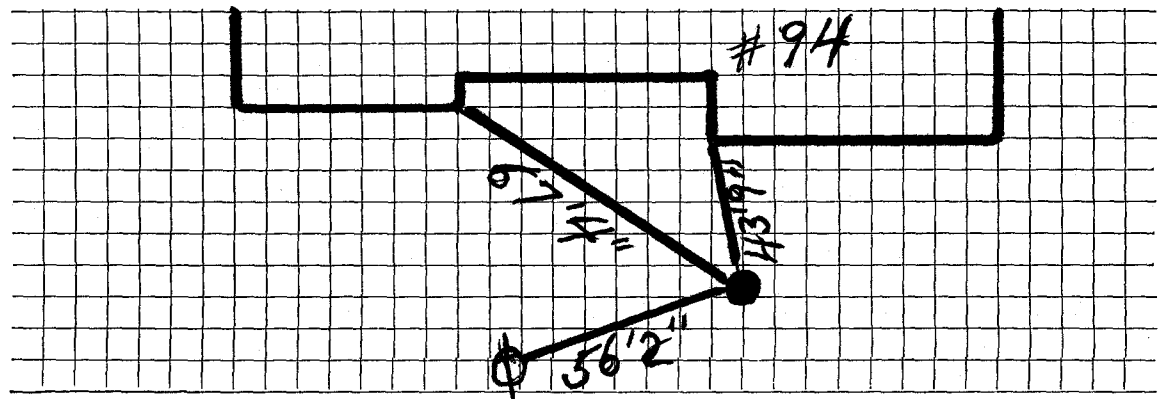

Connection made in \_\_\_\_\_ Street.

Work completed \_\_\_\_\_ 19

Remarks: