

Name Wilbert H. Larson
 52 Milton St.,
 Address Arlington, Massachusetts
 11 Plymouth Rd

Service No. ~~22~~ 2267

Location Lot 29, #11 Plymouth Road.

Kind of Pipe

Size

Size of Main

Repair—Renewal—New Service

Location

Date
1939

Material

Amount

Total

Date

Amount

August 18,
Sum 9/11/39.

2 hrs. @ 60¢
 37' 1" Copper Tubing @ 30¢
 1 1" C.x 1" I. Stop & Waste
 2 hrs. trucking @ 75¢

1 20
 11 10
 3 75
 1 50
 17 55

Aug 16, 1939 Deposited

18 -

Charge Flat Rate: \$18.00

Water & sewer installed to curb in 1936.

Labor

DATE August 9, 1939

TOWN OF LEXINGTON—BOARD OF PUBLIC WORKS

WATER DIVISION

The undersigned applies for a supply of water at No. 11 Plymouth Rd St. and hereby agrees to comply with the rules and regulations as now, or at any future time established by the Board of Selectmen.

Am't. of Estimate \$ 18 - flat rate.

Owner Wilbur H. Larson


Am't. Paid \$ _____

Address 52 Milton Street

Builder W. H. Larson

Arlington, Mass

Sketch of Service Here

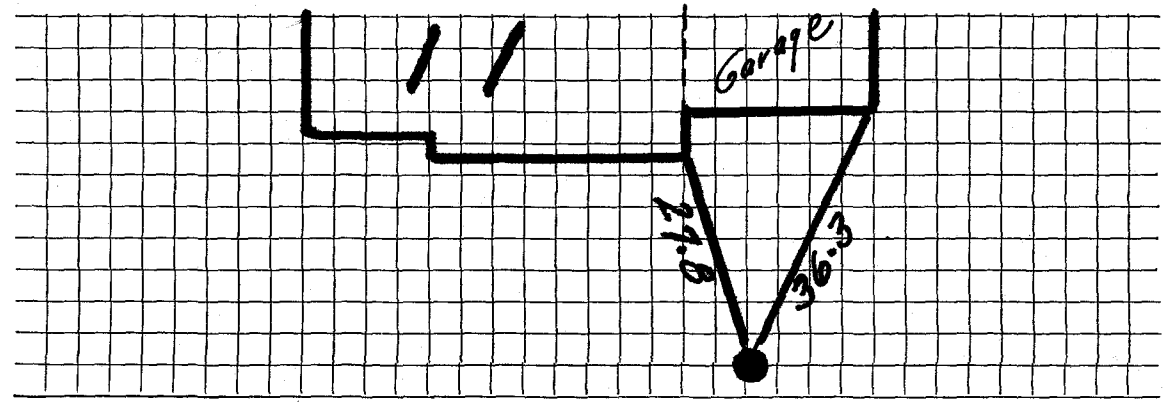

Connection made in _____ Street. Work completed _____ 19

Remarks:

Name W. H. Larson

Service No. ~~87~~ 2266

Address 11 Plymouth Rd.,

Location 9 Plymouth Rd.,

Kind of Pipe

Size

Size of Main

~~Repair—Renewal~~—New Service

Location

Date	Material	Amount	Total	Date	Location	Amount
Oct. 11, 1940	4 hrs. @ 60¢	2 40		October 7, 1940	Separated	18 00
Com 11/8/40	10% Overhead	<u>24</u>	2 64	November 25, 1940	Refunded	6 39
	29' 3/4" copper tubing @ 10¢		5 22			11 61
	1 3/4" C.x 1/2" I.S. & W.		2 25			
	2 hr. trucking @ 75¢		<u>1 50</u>			
			11 61			
	Labor					

Hadley Press, Inc., Lexington

DATE Aug 21, 1940

TOWN OF LEXINGTON—BOARD OF PUBLIC WORKS

WATER DIVISION

The undersigned applies for a supply of water at No. 9 Plymouth St. and hereby agrees to comply with the rules and regulations as now, or at any future time, established by the Board of Selectmen.

Am't. of Estimate \$ W. 18
S. 40

Owner

Ella C. Ritchey


Am't. Paid \$ _____

Address

24 Oakridge Road
Bedford, Mass.

Builder A. Hanson

Sketch of Service Here

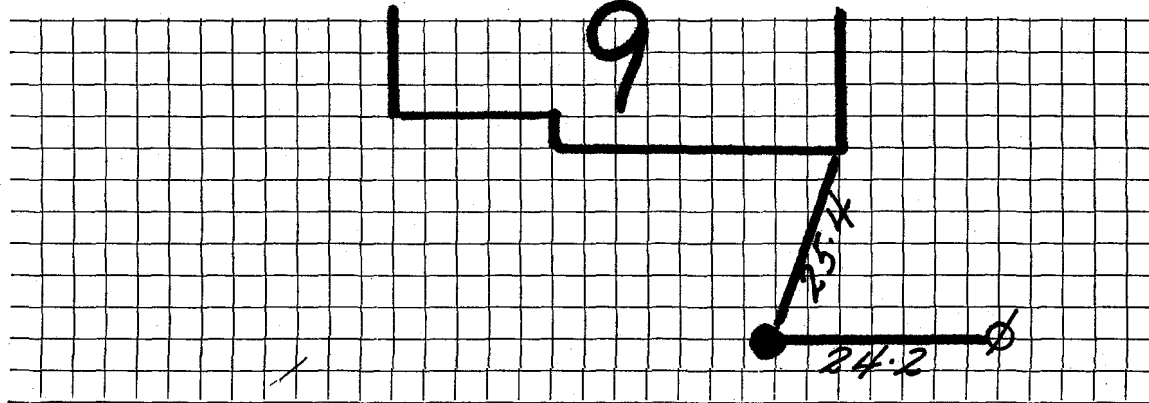

Connection made in _____ Street.

Work completed _____ 19

Remarks: