

Name

James R. Smith

# 3192

Service No.

2268

Address

154 Highland Ave., Arlington

Plymouth Rd.

#12

Location

Lot C, Plymouth Road

Kind of Pipe

Size

Size of Main

~~Repair - Renewal~~ - New Service

Location

Date

Material

Amount

Total

Date

Amount

6/22/34 52' 1" C. Pipe @.20 \$10 40

8-21-34  
Comm. 23.40 1 S & W  
Trucking

2 75  
75 \$13 90

June 20, 1934 - Deposited  
Sept. 27, 1934 - Cash

22 50  
90  
23 40

Charge 52' @ .45

\$23 40 \$23 40

Labor

Hadley Press, Inc., Lexington

50' water  
trench by owner

DATE June 20, 1934

# TOWN OF LEXINGTON—BOARD OF PUBLIC WORKS

## WATER DIVISION

The undersigned applies for a supply of water at No. Lot 6, Plymouth Rd. #12 and hereby agrees to comply with the rules and regulations as now, or at any future time, established by the Board of Selectmen.


Am't. of Estimate \$ 22 <sup>50</sup>

Am't. Paid \$ 22 <sup>50</sup>

53  
22  
275

Owner James R Smith  
Address 154 Highland ave  
Lexington

Builder \_\_\_\_\_

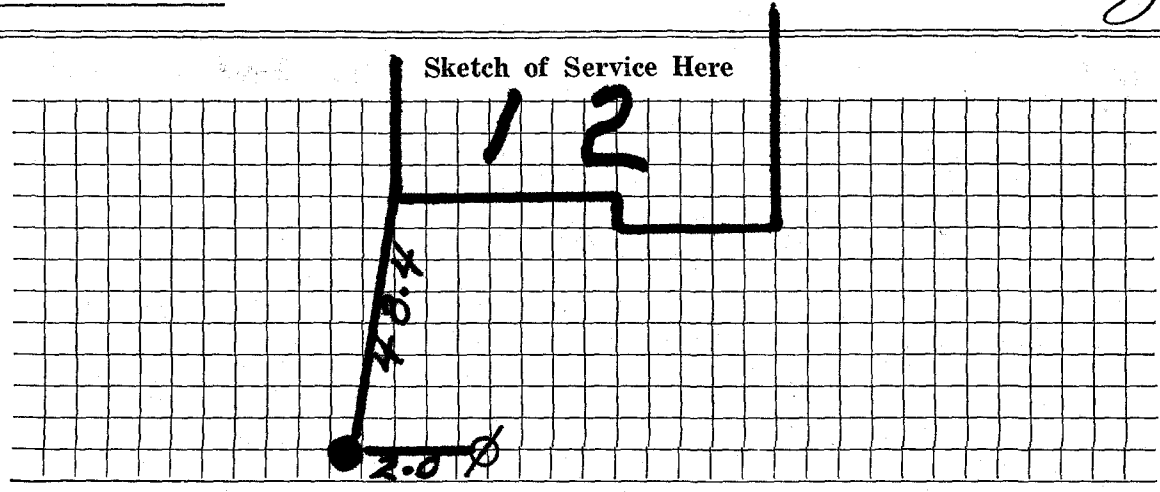

Connection made in \_\_\_\_\_ Street. Work completed \_\_\_\_\_ 19

Remarks: