

Name James R. Smith

Service No. ~~55~~ 2260

Address 54 Highland Ave., Arlington  
2 Plymouth Rd.

# 5328

Location ~~Con. 8th & 9th Rds.~~ & Plymouth Rds. Lot #12

Kind of Pipe

Size

Size of Main

~~Repair - Renewal~~ - New Service

Location

Date	Material	Amount	Total	Date	Amount
D/23/33	33' $\frac{2}{2}$ " C. Pipe @ .15	\$4 95			
Com. 14.85	1 S & W	<u>2 75</u>	\$7 70	AR. 5/10/34	
11-21-33	(Labor on sewer slip)			AR. 7/12/34	
<b>CHARGE</b>	33' @ .45	\$14 85	\$14 85	Sept. 27, 1934 - Cash	14 85
	Labor				

Hadley Press, Inc., Lexington

DATE \_\_\_\_\_

# TOWN OF LEXINGTON—BOARD OF PUBLIC WORKS

## WATER DIVISION

The undersigned applies for a supply of water at No. \_\_\_\_\_ St. and hereby agrees to comply with the rules and regulations as now, or at any future time, established by the Board of Selectmen.


Am't. of Estimate \$ \_\_\_\_\_

Owner \_\_\_\_\_

Am't. Paid \$ \_\_\_\_\_

Address \_\_\_\_\_

Builder \_\_\_\_\_

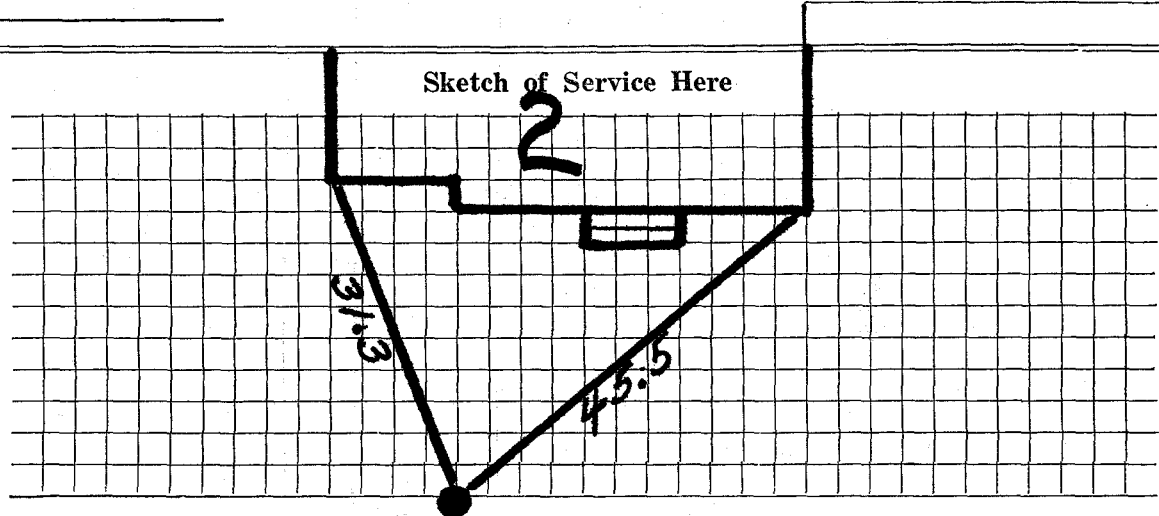

Connection made in \_\_\_\_\_ Street.

Work completed \_\_\_\_\_ 19

Remarks: