

Evelyn Young

WATER SERVICE RECORD

#3604

Name ~~William Sullivan~~

Service No. 244

Address 3 Plymouth Road

Location

Repair—Renewal—New Service


Com 11-25-60

Date	Material	Amount	Total	Date	Amount	
10-27-60	Labor	2.05		10-27-60	25.00	
	10% O.H.	21	2.26	10-27-60	5.61	
38'	3/4" Copper tubing @.42		15.96		24.39	
1	3/4" C x 5 I.W.H. Stop & Waste		6.17			
			24.39			
				10-27-60	Labor	1.94
				15'	3/4" Copper tubing @.42	6.30
				1	3/4" C Corp Cock	4.91
				1	3/4" C Curb Cock	6.28
				1	Bow and Rod	4.90
				1	1/8 Straight tail piece	.50
				1	1/2 Offset tail piece	.50
						25.33

TOWN OF LEXINGTON — BOARD OF PUBLIC WORKS

WATER DIVISION

Sketch of Service Here

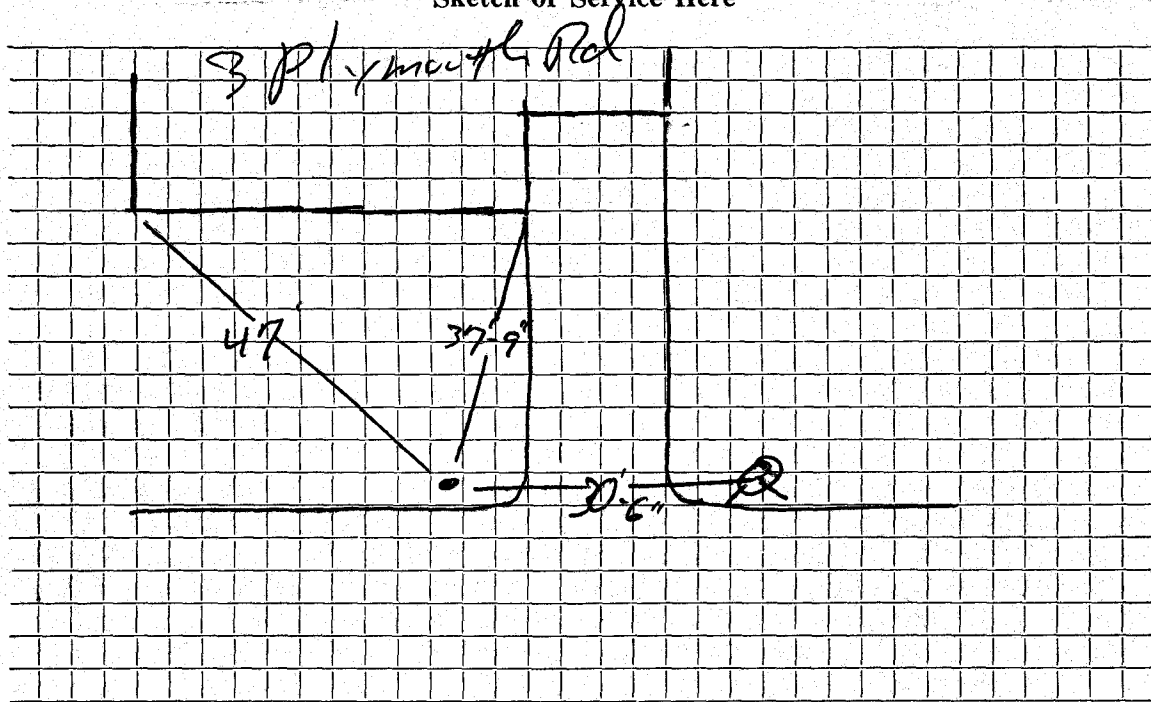

Connection made in Street. Work completed

Remarks:

.....
.....