

Name James R. Smith

Service No. 2261

Address 154 Highland Ave. Arlington

13 4 Plymouth Rd

Location Lot #13, Plymouth Road

#3760
#4568

Kind of Pipe

Size

Size of Main

~~Repair - Renewal~~ - New Service

Location

Date	Material	Amount	Total	Date	Amount
------	----------	--------	-------	------	--------

June, '33

36' 1" Serv. @ .45

\$16 20

AR. 5/7/34

AR. 7/11/34

Sept. 27, 1934 - Cash

16 20

12-1-93

Checked outside
3/4 Copper

Labor

Hibbler Press, Inc., Lexington

Trench dug

DATE July 27, 1933

TOWN OF LEXINGTON—BOARD OF PUBLIC WORKS

WATER DIVISION

The undersigned applies for a supply of water at No. ^{Lot} 13, Plymouth Rd. #4 and hereby agrees to comply with the rules and regulations as now, or at any future time, established by the Board of Selectmen.

Am't. of Estimate \$ _____

Owner


James R. Smith

Am't. Paid \$ _____

Address

154 Highland Ave
Lexington

Builder _____

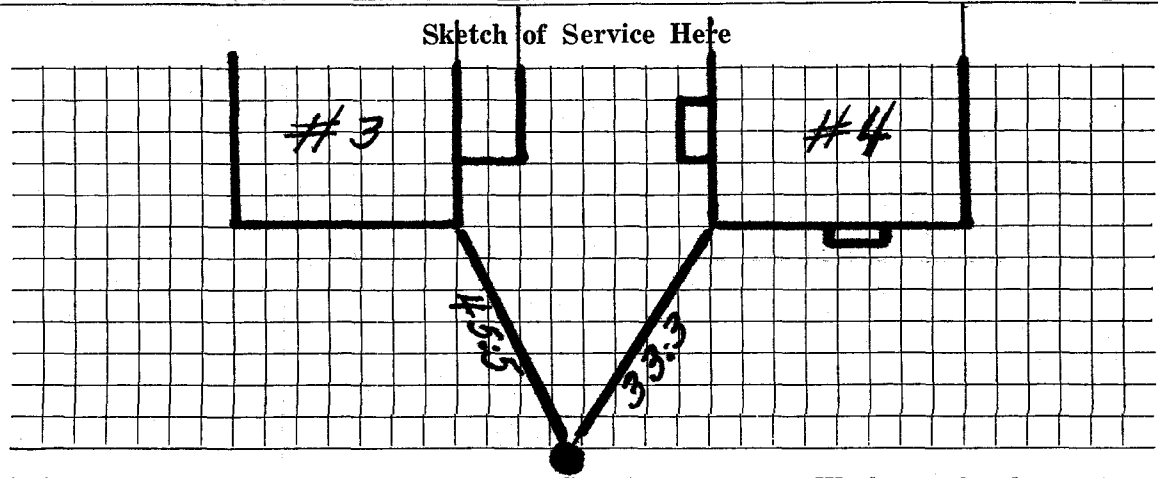

Connection made in _____ Street.

Work completed _____ 19

Remarks: