

Name Mr. James R. Smith

Service No. ~~25~~ 2262

Address 154 Highland Ave., Arlington
21, 5 Plymouth Rd.

4045

Location Lot #21, Plymouth Road

Kind of Pipe

Size

Size of Main

~~Repair - Renewal -~~ New Service

Trench by owner

Location

Date	Material	Amount	Total	Date	Amount
9/20/32	33' 1" C.L. Pipe @.27	\$8 91			
<i>Can. 1980 10-18-32</i>	2 1" L.L. Coup. @.20	40		<i>Alc. 27 1932 - Cash</i>	19 80
	1 1" L.L. Ell	25			
	1 1" Br. Sp. Nip.	15			
	1 S & W	3 00			
	Trucking	75	\$13 46	<i>Apr. 12-19-32 12-2-93</i>	<i>Outside Checked 3/4 Copper</i>
	4 Hrs. Labor @.55	2 20			
	2 " " @.60	1 20	3 40		
	15% overhead		51		
	COST		\$17 37		
	CHARGE 33' @ .60	\$19 80	\$19 80		
	Labor				

Hadley Press, Inc., Lexington

French dug by owner

DATE Sept. 17, 1932.

TOWN OF LEXINGTON—BOARD OF PUBLIC WORKS

WATER DIVISION

The undersigned applies for a supply of water at No. ^{Lot} 21, Plymouth Rd. St. ^{#5} and hereby agrees to comply with the rules and regulations as now, or at any future time, established by the Board of Selectmen.

Am't. of Estimate \$ _____

Owner


James R. Smith

Am't. Paid \$ _____

Address

*154 Highland Ave
Lexington*

Builder _____

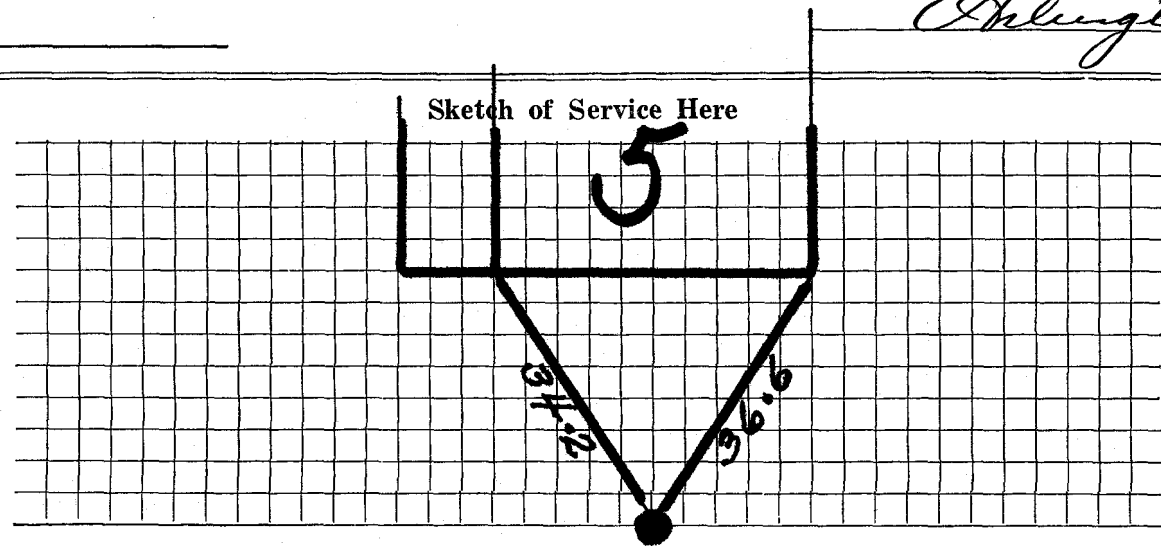

Connection made in _____ Street.

Work completed _____ 19

Remarks: