

Name

Custance Bros.

Service No.

2263

Address

54 Bedford St.  
6, 14 Plymouth Rd

Location

#6  
Lot #14, Plymouth Road

Kind of Pipe

Size

Size of Main

~~Repair~~ ~~Renewal~~ - New Service

Location

Date

Material

Amount

Total

Date

Amount

Com. 21.60 36' 1" Copper Pipe @.17

6 12

Nov. 12, 1935 - Abated

21.60

12-31-32 1 S & W

2 75

Trucking

75

9 62

10/14/32 7 Hrs. Labor @.55

3 85

2 " " @.60

1 20

5 05

Apr. 4-26-33

15% Overhead

76

Apr. 3-30-34

COST

15 43

CHARGE 36' @ .60

\$21 60

\$21 60

Labor

Haley Press, Inc., Lexington

DATE ED 8-32

# TOWN OF LEXINGTON—BOARD OF PUBLIC WORKS WATER DIVISION

The undersigned applies for a supply of water at No. #6 Plymouth St. and hereby agrees to comply with the rules and regulations as now, or at any future time, established by the Board of Selectmen.

Am't. of Estimate \$ \_\_\_\_\_

Lot # 14

Owner

Estimate Buss.

Am't. Paid \$ \_\_\_\_\_


Address

27. 46 E. Estimate  
54 Bedford St

Builder \_\_\_\_\_

Lexington

Sketch of Service Here

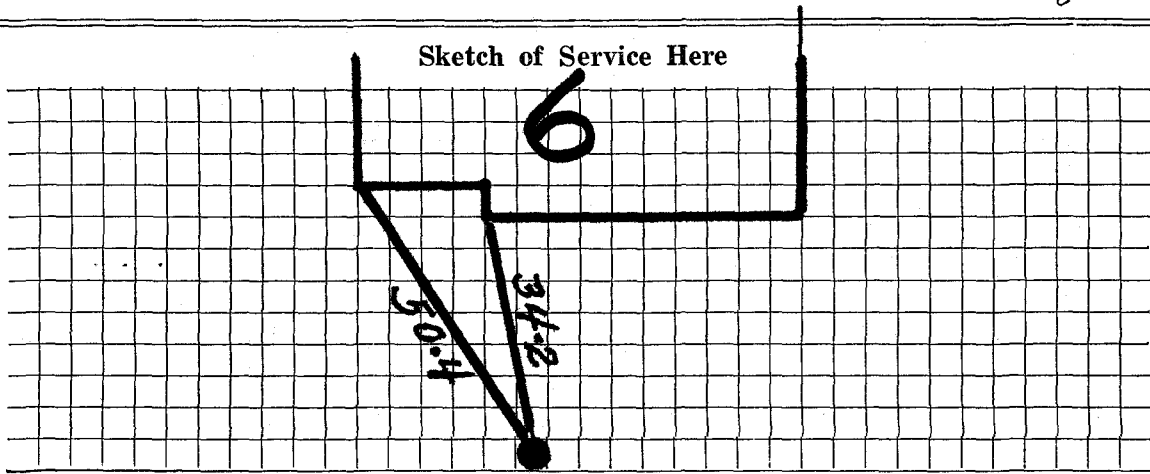

Connection made in \_\_\_\_\_ Street.

Work completed \_\_\_\_\_ 19

Remarks: