

Name **James R. Smith**

Service No. **2264**

Address **154 Highland Avenue, Arlington**

4033 #5009

7, 20 Plymouth Rd.

#7

Location **Lot 20 Plymouth Rd., Lexington**

Kind of Pipe

Size

Size of Main

~~REPAIR~~ **New Service**

Location

Date	Material	Amount	Total	Date	Amount
<i>Comm. 14.63</i>					
<i>5-8-34</i>	32 $\frac{1}{2}$ " 3/4" C. Pipe @.18	\$5 85			
4/21/34	1 S & W	2 75			
	Trucking	75	\$9 35		
	2 Hrs. Labor @.60	1 20	<u>1 20</u>		
	<u>COST</u>		\$10 55		
<u>CHARGE</u>	32 $\frac{1}{2}$ " @ .45	\$14 63	\$14 63	<i>April 18, 1934 - Cash -</i>	14 63
	Labor				

Hadley Press, Inc. Lexington

DATE April 15, 1934.

TOWN OF LEXINGTON—BOARD OF PUBLIC WORKS

WATER DIVISION

The undersigned applies for a supply of water at No. ^{Lot} 20 Plymouth Road #7 St. and hereby agrees to comply with the rules and regulations as now, or at any future time, established by the Board of Selectmen.

Am't. of Estimate \$ 12

Am't. Paid \$ _____


Builder _____

Owner

Address

James Smith
154 Highland Ave
Lexington

Sketch of Service Here

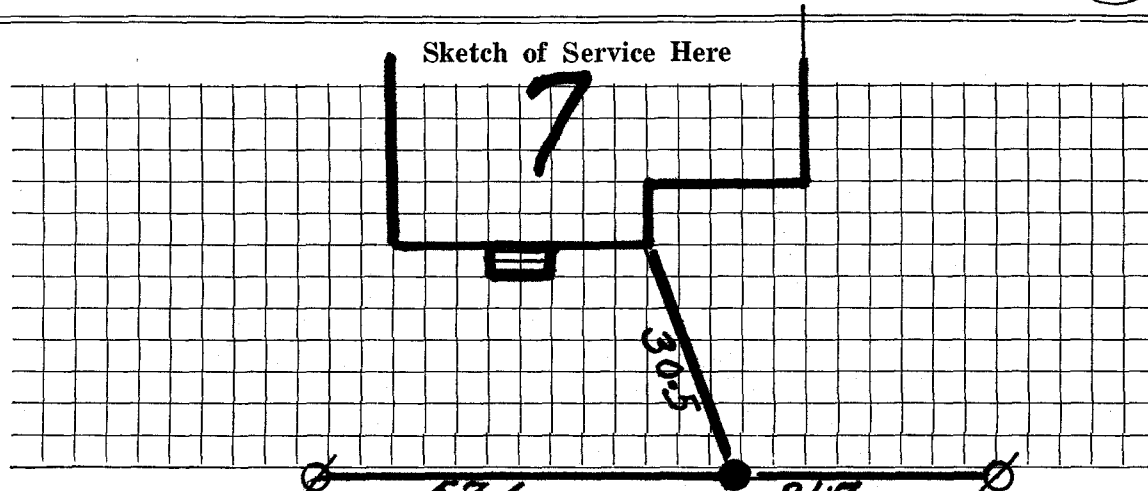

Connection made in _____

57.6 Street.

21.7 Work completed

19

Remarks: