

Name James R. Smith

Service No. 2265

Address 154 Highland Ave., Arlington
8 Plymouth Rd.

Location Lot A, Plymouth Rd.

Kind of Pipe

Size

Size of Main

~~Repair-Renewal~~ - New Service

Location

Date	Material	Amount	Total	Date	Amount
8/15/34	38' 1" C. Pipe @ .20	7 60			
9-25-34 Russell-17.10	1 S & W Trucking	2 75			
		75	\$11 10		
	6 Hrs. Labor @ .55	3 30			
	4 " " @ .60	2 40	5 70		
	10% Overhead		57		
	COST		17 30		
	CHARGE 38' @ .45	\$17 10	\$17 10		
	Labor				

Sept. 19 1934 - Deposited

17 10

Haley Press, Inc., Lexington

25-

DATE August 18, 1934

TOWN OF LEXINGTON—BOARD OF PUBLIC WORKS

WATER DIVISION

The undersigned applies for a supply of water at No. 10 Plymouth Rd. #8 St. and hereby agrees to comply with the rules and regulations as now, or at any future time, established by the Board of Selectmen.

Am't. of Estimate \$ _____

Owner

James Smith

Am't. Paid \$ _____


Address

154 Highland Ave

Builder _____

Lexington Mass.

Sketch of Service Here

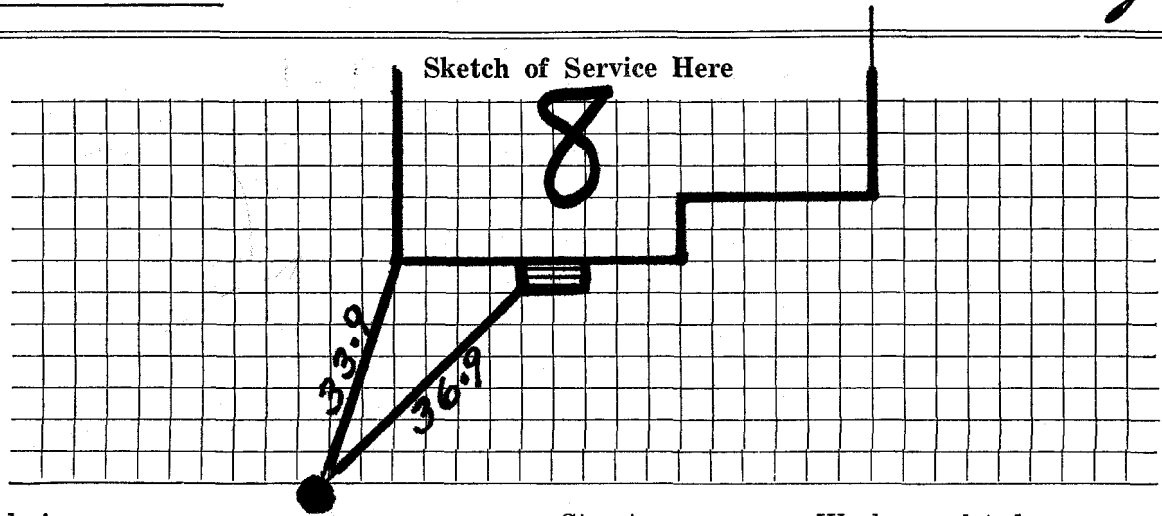

Connection made in _____ Street.

Work completed _____ 19

Remarks: