




DATE March 3 2006

TOWN OF LEXINGTON — BOARD OF PUBLIC WORKS  
**WATER DIVISION**

Sketch of Service Here

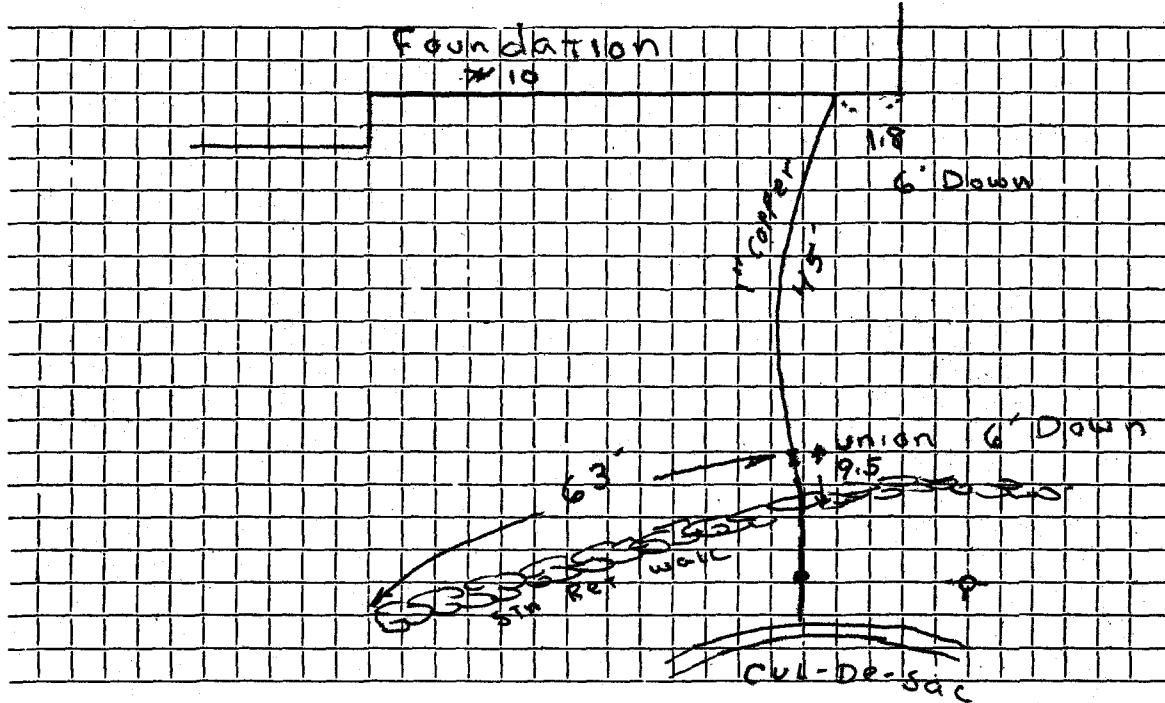

Connection made in Porter Lane Street. Work completed .....

Remarks: .....