




DATE 9-19-00

TOWN OF LEXINGTON — BOARD OF PUBLIC WORKS

WATER DIVISION

Sketch of Service Here

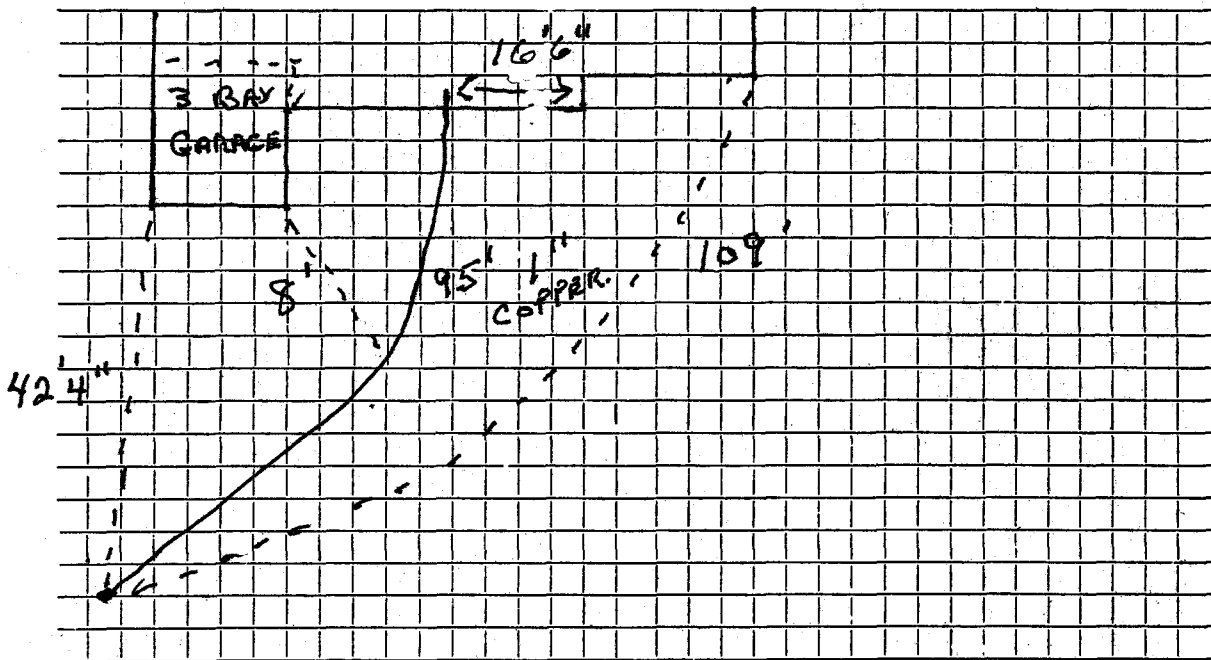

Connection made in ... PORTER LN ... Street. Work completed .....

Remarks: INSTALLED ... by ... J. McLAUGHLIN .....