


DATE 10-1-2001

TOWN OF LEXINGTON — BOARD OF PUBLIC WORKS

WATER DIVISION

Sketch of Service Here

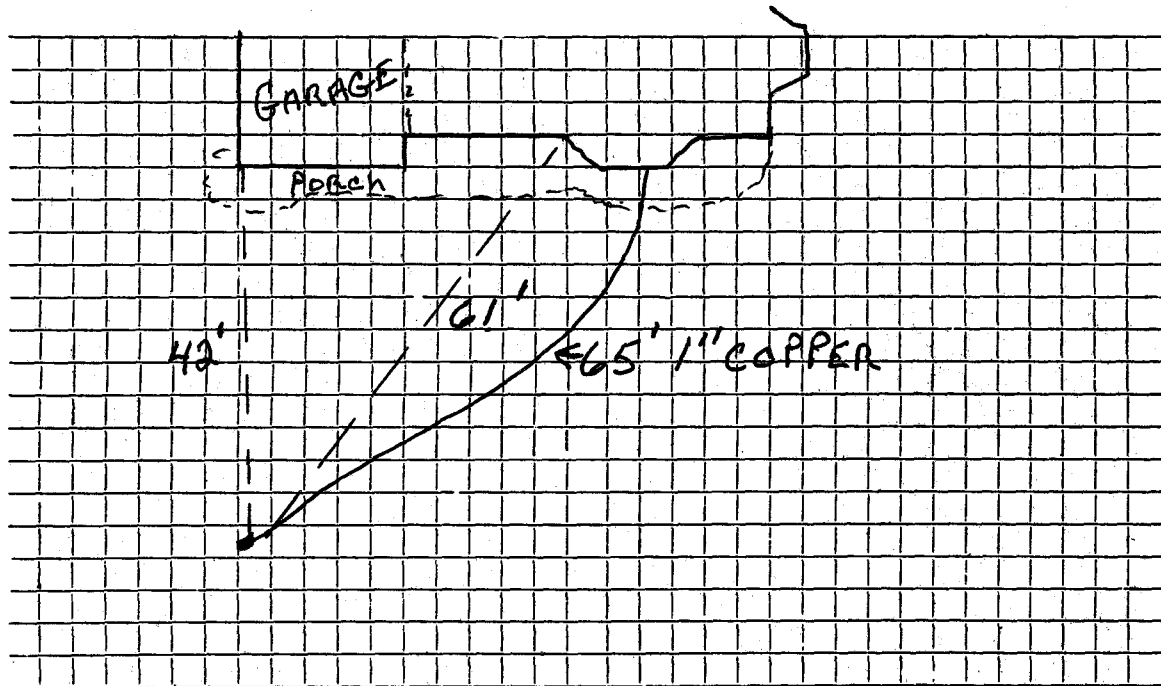

Connection made in PORTER LN Street. Work completed

Remarks: INSTALLED BY J. McLAUGHLIN