


DATE 12-20-99

TOWN OF LEXINGTON — BOARD OF PUBLIC WORKS

WATER DIVISION

Sketch of Service Here

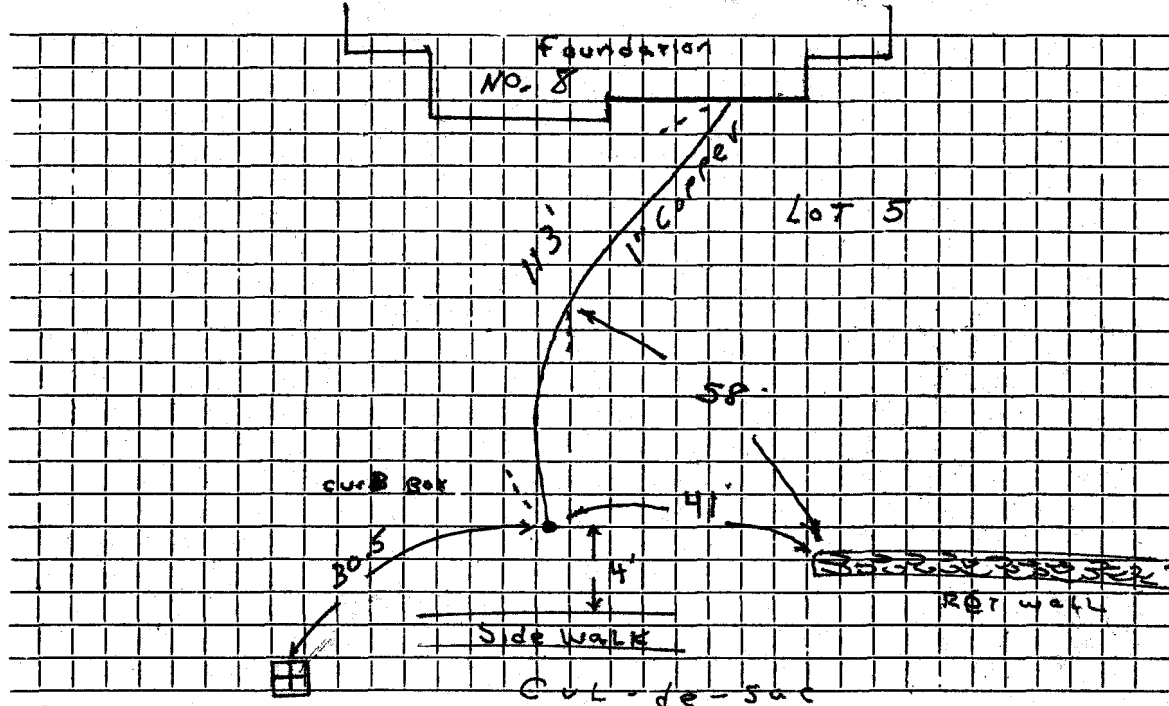

Connection made in Porter Lane Street. Work completed

Remarks: