

WATER SERVICE RECORD

Name Edwin S. Johnston

Service No. 46

Address 10 Preston Road

Location Lexington

~~REPAIR CHARGE~~ - New Service Com. 3/30/53

Date	Material	Amount	Total	Date	Amount
3/10/53	Labor	1 63		3-2-53	25 -
	10% overhead	16	1 79	3-30-53	2 48
	47' -3/4" copper tubing @ .34	15 98			22 52
	1 -3/4"C x 1/2 I.W.H. stop & waste	4 00		3/10/53	1 -1/2 straight tail piece 50
	1 hr. trucking		75		1 -1/2 offset tail piece 50
			22 52		1 00

Deposited

Refunded

NON CHARGE

SERVICE ~~WAS IN~~ TO CURB:


9-15-52 Renewal
 10' 3/4" Copper
 1 3/4"C. Corp Cock
 1 3/4"C. X 3/4"C. Curb Cock
 1 Box + Rod

DATE _____

TOWN OF LEXINGTON — BOARD OF PUBLIC WORKS

WATER DIVISION

Sketch of Service Here

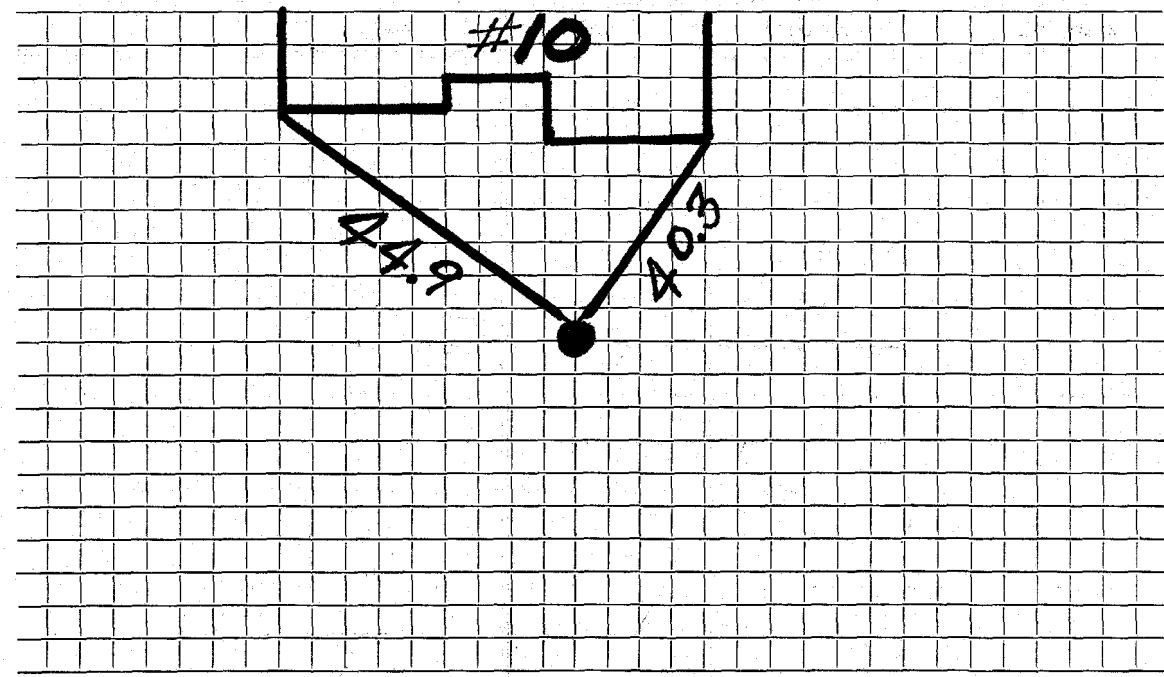

Connection made in Street. Work completed

Remarks:
.....
.....