

Name Benjamin J. Gott

Service No. 245

Address 11 Preston Road

Lexington, Mass.

Location 11 Preston Road

2448, 7756

Kind of Pipe

Size

Size of Main

~~Repair~~ ~~XXXXXX~~ New Service

Com. 12-5-49

Location

Date	Material	Amount	Total	Date	Amount
Nov. 23, '49	Labor	2 40	2 40	Nov. 14 '49	20 00
	10% Overhead		24	Dec. 22 '49	5 88
	31' - 3/4" Copper Tubing @ .24	7 44	7 44		14 12
	1 - 3/4" C x 1/2" I.W.H. S&W	3 29	3 29	Nov. 23, '49	2 40
	Trucking 1 hr. @ .75	75	75		7 44
			14 12	31' - 3/4" Copper Tubing @ .24	7 44
				1 - 3/4" C Corp-cock	3 15
				1 - 3/4" C x 3/4" C Curb-cock	3 85
				1 - Box & Rod	3 75
				1 - 1/2" Offset Tail Piece	37
				1 - 1/2" Straight Tail Piece	37
				Littlefield Shovel 2 hrs. @ 7.00	14 00
				Trucking 1 hr. @ .75	75
	Labor				36 08

DATE _____

TOWN OF LEXINGTON – BOARD OF PUBLIC WORKS

WATER DIVISION

The undersigned applies for a supply of water at No..... St. and hereby agrees to comply with the rules and regulations as now, or at any future time, established by the Board of Selectmen.

Am't of Estimate \$.....

Owner


Am't Paid \$.....

Address

Builder

.....

Sketch of Service Here

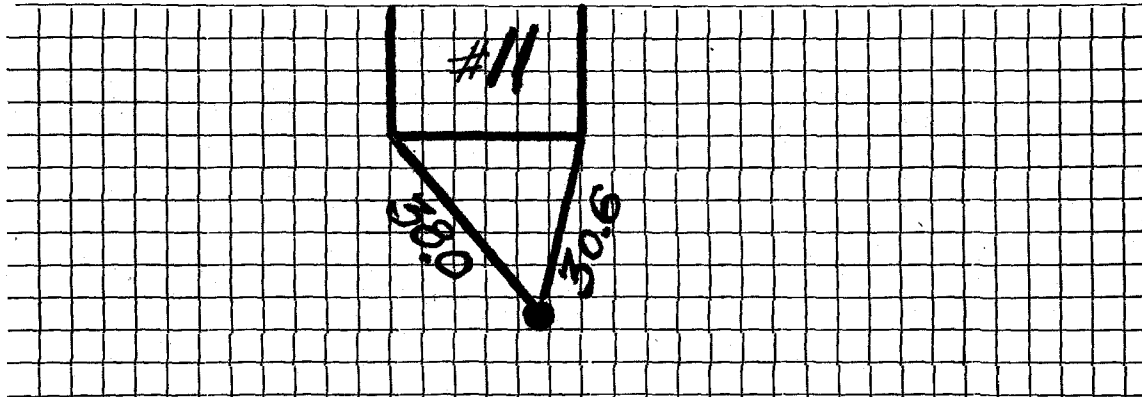

Connection made in Street.

Work completed19

Remarks: