

WATER SERVICE RECORD

207

Name Custance Brothers

Service No. 348

Address 15 Preston Road

Location Lexington, Mass.


~~Repair & Renewal~~ New Service Com. 12-26-50

Date	Material	Amount	Total	Date	Amount
Nov. 25, '50	Labor	3 05	3 05	Nov. 25, '50	Deposited 80 00
	10% Overhead		31		
	32' - 3/4" Copper Tubing @ .334	10 69			No Charge 27 12
	1 - 3/4"C x 1/2" I.W.H. S&W	3 76		Nov. 25, '50	Labor 3 05
	1 - 3/4"C x 3/4" Union (3pts)	1 61			30' - 3/4" Copper Tubing @ .334 10 02
	Littlefield Shovel 1 hr. @ 7.00	7 00			1 - 3/4"C Corp-cock 3 60
	Trucking 1 hr. @ .75		75		1 - 3/4"C x 3/4" Curb-cock 4 40
			27 17		1 - Box & Rod 3 35
					1 - 1/2" Offset Tail Piece 42
					1 - 1/2" Straight Tail Piece 42
					Littlefield Shovel 2 hrs. @ 7.00 14 00
					Trucking 1 hr. @ .75 75
					40 01

DATE _____

TOWN OF LEXINGTON — BOARD OF PUBLIC WORKS
WATER DIVISION

Sketch of Service Here

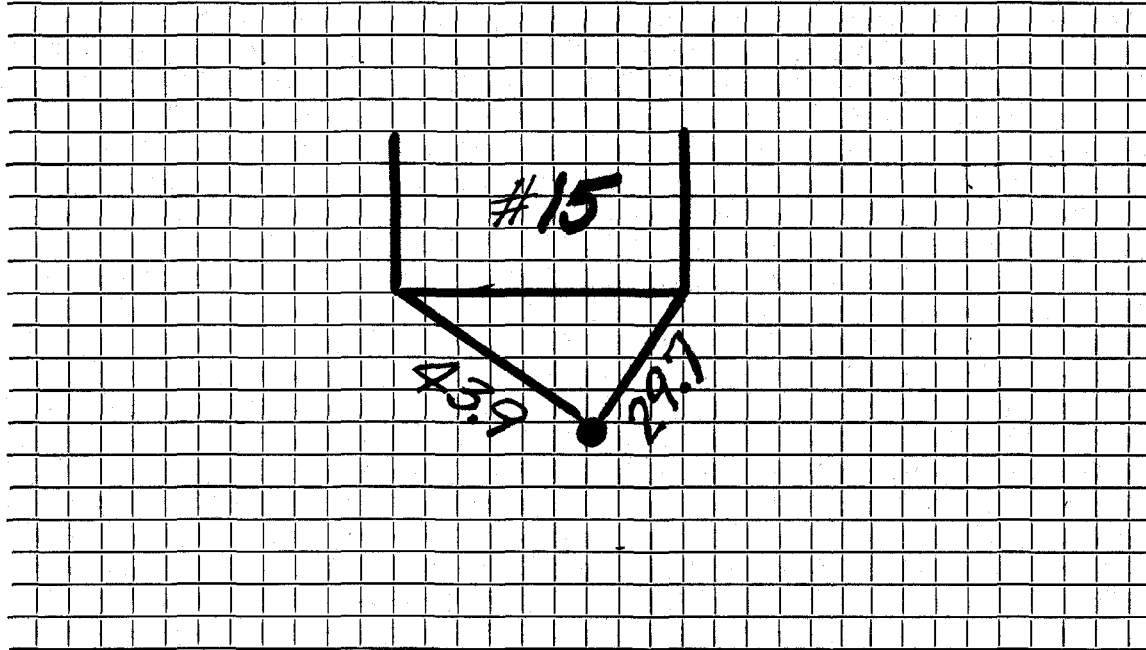

Connection made in Street. Work completed

Remarks:
.....
.....