

Name Roger Patrie

Service No. 69

Address 17 Preston Road

#5776

Lexington, Mass.

Location 17 Preston Road

Kind of Pipe

Size

Size of Main

~~XXXXXXXXXX~~ - New Service Com. 7-3-50

Location

Date	Material	Amount	Total	Date	Amount
Apr. 28, '50	Labor	3 97	3 97	Apr. 26, '50	Deposited 30 00
	10% Overhead		40	July 20 '50	Refunded 72
	29' - 3/4" Copper Tubing @.23	6 67	6 67		No Charge 29 08
	1 - 3/4"C x 1/2" I.W.H. S&W	3 29	3 29	Apr. 28, '50	Labor 6 00
	Shovel 2 hrs. @ 7.00		14 00	20' - 3/4" Copper Tubing @.23	4 68
	Trucking 1 hr. @.75		75	1 - 3/4"C Corp-cock	3 15
			29 08	1 - 3/4"C x 3/4"C Curb-cock	3 85
				1 - Box & Rod	3 35
				1 - 1/2" Straight Tail Piece	38
				1 - 1/2" Offset Tail Piece	38
				Littlefield Shovel 2 hrs. @7.00	14 00
				Trucking 1 hr. @.75	75
	Labor				36 46

DATE \_\_\_\_\_

TOWN OF LEXINGTON - BOARD OF PUBLIC WORKS

**WATER DIVISION**

The undersigned applies for a supply of water at No..... St. and hereby agrees to comply with the rules and regulations as now, or at any future time, established by the Board of Selectmen.

Am't of Estimate \$.....

Owner .....


Am't Paid \$.....

Address .....

Builder .....

.....

Sketch of Service Here

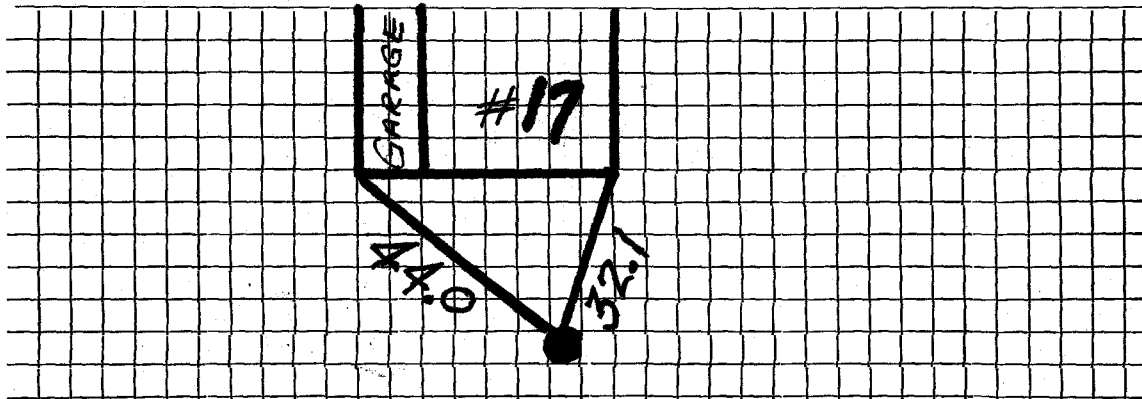

Connection made in ..... Street.

Work completed .....19

Remarks: