

Name Wesley R. Colwell

Service No. #2269

Address 122 Rawson Road, Arlington, Mass.

#4380

2 Preston Rd.

Location ~~Con. Simonds~~ & Preston Roads #2

Kind of Pipe

Size

Size of Main

Repair—Renewal—New Service

Location

Date	Material	Amount	Total	Date	Amount
7.21-34 7/15-30	35' 3/4" C. Pipe @.18	\$6 30			
	1 S & W	2 75			
	Trucking	75	\$9 80	July 24 1934 - Deposited	10 50 ✓
				July 16 1934 - Cash	4 50
					15 30
7/19	4 Hrs. Labor @.55	2 20			
	2 " " @.70	1 40	3 60		
	10% overhead		36		
	<b>COST</b>		13 76		
	(Am't. collected)				
	CHARGE 34' @ .45	\$15 30	\$15 30		
	Labor				
				7-21-65	ADTS

Hidley Bros. Inc., Lexington

24'  
24  
42  
120  
96  
10.80

DATE June 27, 1934

# TOWN OF LEXINGTON—BOARD OF PUBLIC WORKS

## WATER DIVISION

The undersigned applies for a supply of water at No. Cor. Simonds & Preston St. and hereby agrees to comply with the rules and regulations as now, or at any future time, established by the Board of Selectmen.

Am't. of Estimate \$ 10.00

Owner Wesley R. Colwell


Am't. Paid \$ 10.00

Address 125 Rawson Rd  
Arlington Mass.

Builder \_\_\_\_\_

*Owner to dig own trench*

Sketch of Service Here

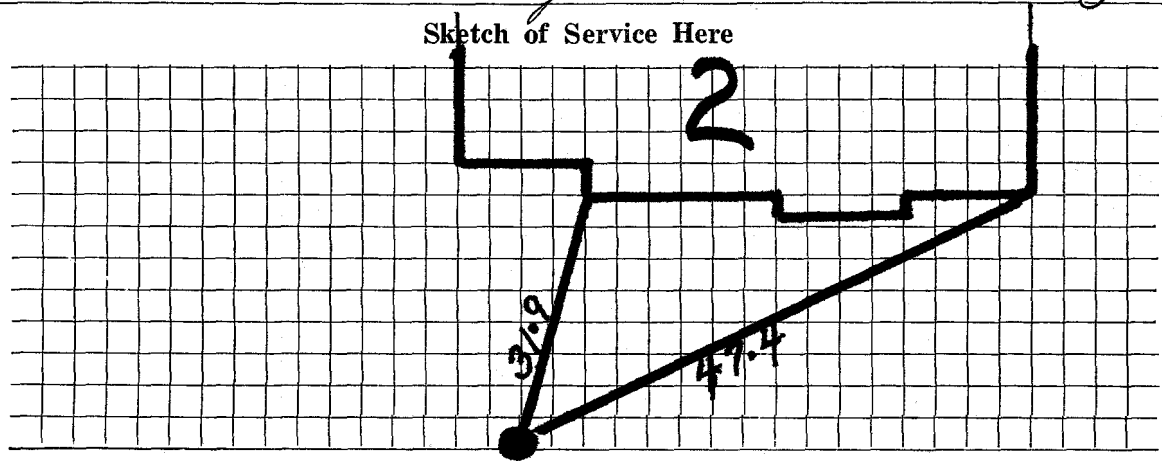

Connection made in \_\_\_\_\_ Street.

Work completed \_\_\_\_\_ 19

Remarks: