

Name Roger Petrie *C mail address 2 Grove St.*

Service No. 211

Address 21 Preston Road
Lexington, Mass.

Location

Kind of Pipe

Size

Size of Main

~~Repair~~ ~~Renewal~~ ~~New Service~~

Com. 11-6-50

Location

Date	Material	Amount	Total	Date	Amount
Aug. 26, '50	Labor	8 52	8 52	Aug 9 '50	40 00
	10% Overhead		85	8-17-51	7 69
	75' - 3/4" Copper Tubing @.275	20 63		12-13-54	8 74
	1 - 3/4"C x 1/2" I.W.H. S&W	3 29			
	1 - 3/4"C x 3/4"C Union (3pts)	1 39			
	Littlefield Shovel 3 hrs. @7.00	21 00			
	Trucking 1 hr. @.75		75		
			56 43		
	<i>Bill sent 4-7-50</i>				
	<i>" " 3-7-52</i>				
	Labor				

Hadley Press, Inc., Lexington

Deposited
Paid
Paid
No Charge
Service was in to curb

40 00
7 69
8 74
56 43

DATE _____

TOWN OF LEXINGTON—BOARD OF PUBLIC WORKS

WATER DIVISION

The undersigned applies for a supply of water at No. _____ St. and hereby agrees to comply with the rules and regulations as now, or at any future time, established by the Board of Selectmen.

Am't. of Estimate \$ _____


Owner _____

Am't. Paid \$ _____

Address _____

Builder _____

Sketch of Service Here

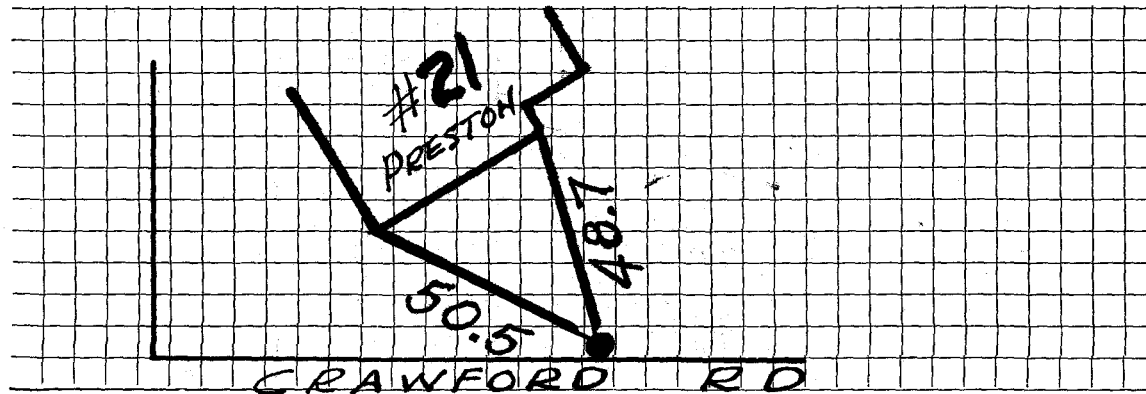

Connection made in _____ Street.

Work completed _____ 19

Remarks: