

WATER SERVICE RECORD

Name John Galt

Service No. 195

Address 25 Preston Road

#6975

Location Lexington, Mass.


Repair ~~at work~~ - New Service COM.10-15-51

Date	Material	Amount	Total	Date	Amount
9-18-51	Labor	5 52	5 52	8/16/51	Deposited 60 00
	10% Overhead		55	10/20/51	Paid 1 21
	45'-3/4" Copper Tubing @.326		14 67		No Charge 01 21
	1-3/4" Cx 1/2 I.W.H. S&W		4 00	9-20-51	Labor 5 52
	1-3/4" Cx 3/4" C Union (3 pts)		1 72	30'-3/4" Copper Tubing	9 78
	2 Hrs. Littlefield Shovel		14 00	1-3/4" C. Corp-Cock	4 33
	1 Hr. Trucking		75	1-3/4" Cx 3/4" C Curb cock	4 67
	Patching 20x3		20 00	1 Box & Rod	4 68
			61 21	1-1/2 offset tail piece	50
				1-1/2 straight tail piece	50
				2 Hrs. Littlefield Shovel	14 00
				1 Hr. Trucking	75
					44 73
					bill sent 10-15-51

DATE \_\_\_\_\_

TOWN OF LEXINGTON — BOARD OF PUBLIC WORKS  
WATER DIVISION

Sketch of Service Here

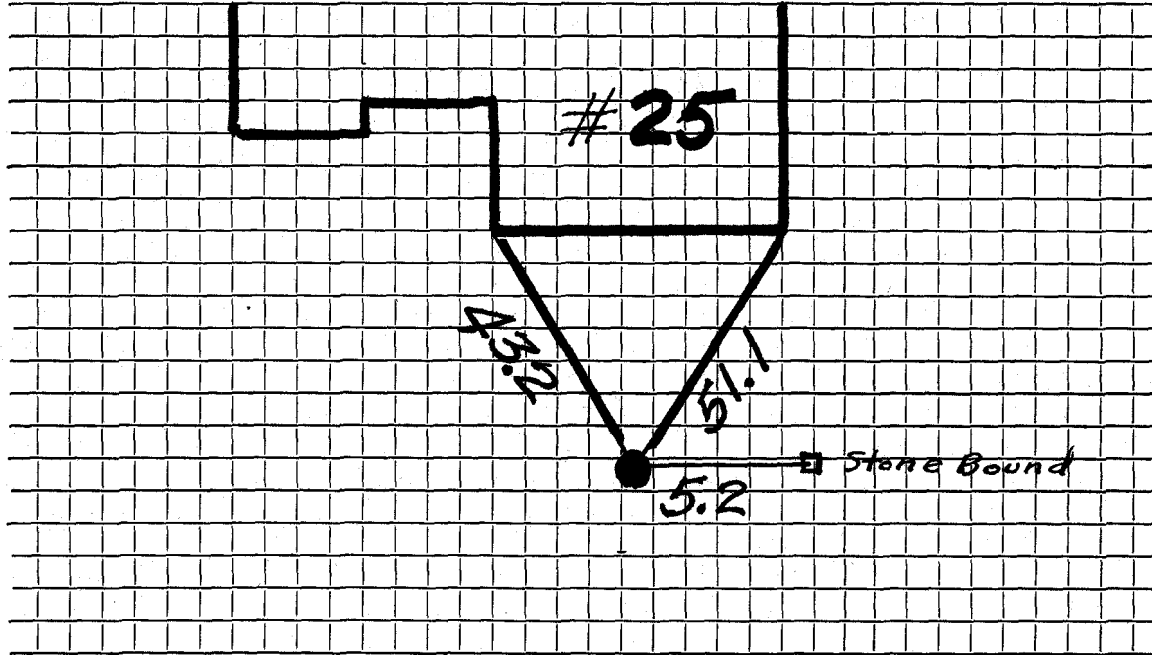

Connection made in ..... Street.                      Work completed .....

Remarks: .....

.....  
.....