

Name **David Evans**Service No. ¹⁴²

3387

Address **3 Preston Road**Location **3 Preston Road**

Kind of Pipe

Size

Size of Main

~~REGULAR SERVICE~~ New Service

Com 12-1-47

Location

Date	Material	Amount	Total	Date	Amount
Oct. 24, '47	Labor	1 10	1 10	Oct 14 47	Deposited 20 00
	10% Overhead		11	Dec 4 47	Refunded 4 23
	41' - 3/4" Copper Tubing @ .26	10 66			Non-Charge 15 07
	1 - 3/4" C x 1/2" I/W.H. S & W	3 15		Oct. 24, '47	Labor 1 10
	Trucking 1 hr. @ .75	75			32' - 3/4" Copper Tubing @ .26 8 32
			15 77		1 - 3/4" C Corp-cock 3 00
					1 - 3/4" C x 3/4" C Curb-cock 3 68
					1 - Box & Rod 4 26
					2 - 1/2" Straight Tail Pieces 60
					Trucking 1 hr. @ .75 75
					<u>21 71</u>
	Labor				

TOWN OF LEXINGTON - BOARD OF PUBLIC WORKS
WATER DIVISION

The undersigned applies for a supply of water at No..... St. and hereby agrees to comply with the rules and regulations as now, or at any future time, established by the Board of Selectmen.

Am't of Estimate \$.....


Owner

Am't Paid \$.....

Address

Builder

900 Lexington St. Wallham Man
Sketch of Service Here

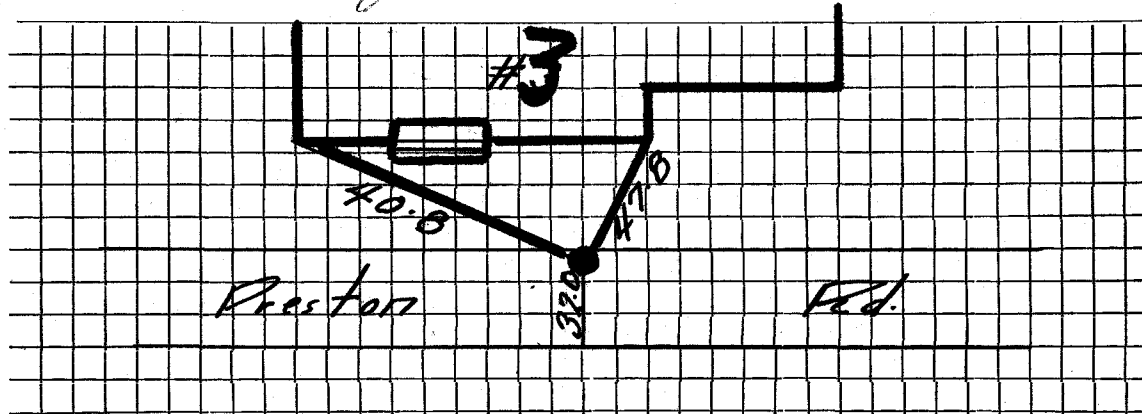

Connection made in Street.

Work completed19

Remarks: