

Name Louis Stocio
 Address 30 Preston Road
 Lexington, Mass.

Service No. 101 #4372

Location 30 Preston Road

Kind of Pipe

Size

Size of Main

~~Repair-Renewal~~ - New Service

Com. 8-23-48

Location

Date	Material	Amount	Total	Date	Amount
Jul. 15, '48	Labor	1 15	1 15	July 9 '48	Deposited 25 00
	10% Overhead		12	Aug 20 '48	Expended 6 01
	49' - 3/4" Copper Tubing @.255	12 50			Non-Charge 18 99
	1 - 3/4" C x 1/2" I.W.H. S & W	3 15		Jul. 15, '48	Labor 3 95
	1 - 3/4" C x 3/4" C Union(3pts)	1 32		17' - 3/4" Copper Tubing @.255	4 34
	Trucking 1 hr. @.75	75	18 99	1 - 3/4" C Corp-cock	3 00
	trench dug by owner.			1 - 3/4" C x 3/4" Curb-cock	3 68
				1 - Box & Rod	3 55
				Littlefield Shovel 2 1/2 hrs.@7.00	17 50
				1 - 1/2" Offset Tail Piece	30
				1 - 1/2" Straight Tail Piece	30
				Trucking 1 hr. @.75	75
	Labor				37 37

Hadley Press, Inc., Lexington

DATE _____

TOWN OF LEXINGTON—BOARD OF PUBLIC WORKS

WATER DIVISION

The undersigned applies for a supply of water at No. _____ St. and hereby agrees to comply with the rules and regulations as now, or at any future time, established by the Board of Selectmen.

Am't. of Estimate \$ _____


Owner _____

Am't. Paid \$ _____

Address _____

Builder _____

Sketch of Service Here

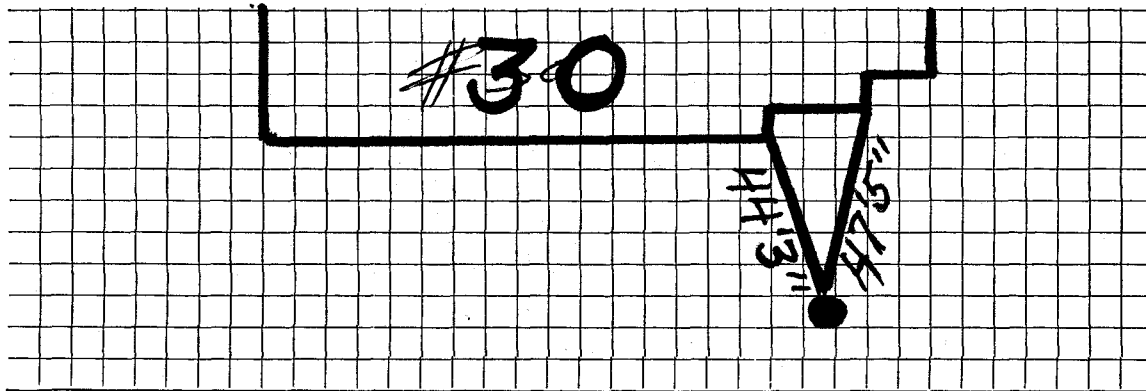

Connection made in _____ Street.

Work completed _____ 19

Remarks: