

Name Winston Johnson

Service No. 209

Address 31 Preston Road

Lexington, Mass.

Location 31 Preston Road

220

Kind of Pipe

Size

Size of Main

~~Repair - Renewal~~ - New Service

Com. 11-6-50

Location

Date	Material	Amount	Total	Date	Amount
Sept. 1, '50	Labor	3 10	3 10	Aug 7 '50	50 00
	10% Overhead		31		
	45' - 3/4" Copper Tubing @.275	12 38			
	1 - 3/4"C x 1/2" I.W.H. S ^W	3 29		Sept. 1, '50	Labor 10 00
	Littlefield Shovel 3 hrs. @7.00	21 00		28' - 3/4" Copper Tubing @.275	7 70
	Trucking 1 hr. @.75	75		1 - 3/4" Corp-cock	3 15
			40 83	1 - 3/4"C x 3/4"C Curb-cock	3 85
				1 - Box & Rod	3 35
				1 - 1/2" Straight Tail Piece	42
				1 - 1/2" Offset Tail Piece	42
				Littlefield Shovel 2 hrs. @7.00	14 00
				Trucking 1 hr. @.75	75
	Labor				43 64

Deported

No Charge

50 83

10 00

7 70

3 15

3 85

3 35

42

42

14 00

75

43 64

DATE _____

TOWN OF LEXINGTON—BOARD OF PUBLIC WORKS

WATER DIVISION

The undersigned applies for a supply of water at No. _____ St. and hereby agrees to comply with the rules and regulations as now, or at any future time, established by the Board of Selectmen.

Am't. of Estimate \$ _____


Owner _____

Am't. Paid \$ _____

Address _____

Builder _____

Sketch of Service Here

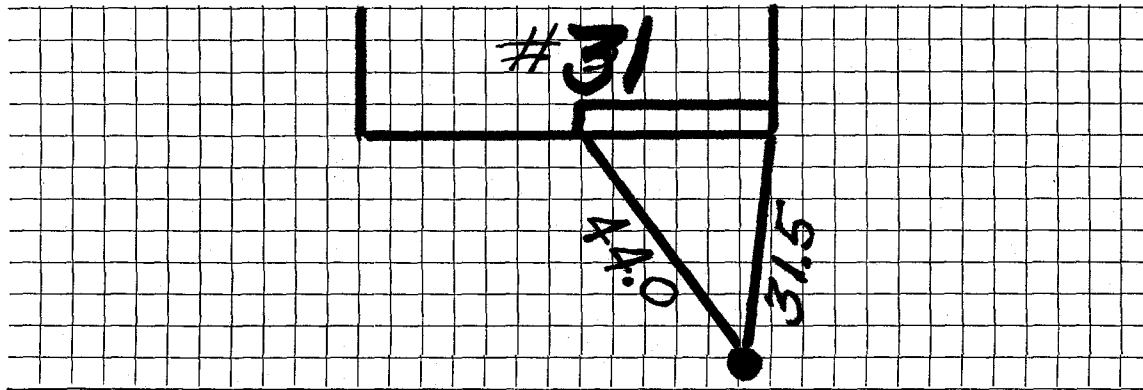

Connection made in _____ Street.

Work completed _____ 19

Remarks: