


DATE _____

TOWN OF LEXINGTON — BOARD OF PUBLIC WORKS

WATER DIVISION

Sketch of Service Here

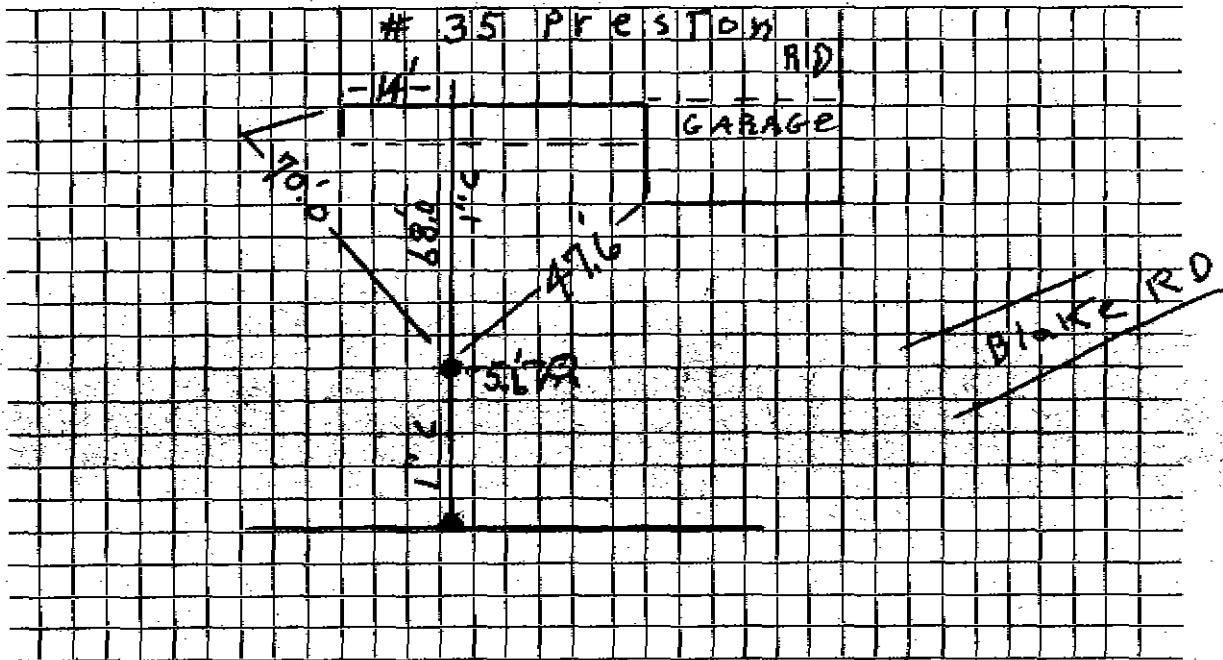

Connection made in _____ Street.

Work completed 11/28/08 J. McLaughlin

Remarks: Fire Hyd To Curb 5'6"