

Name *Frances G. Shea*  
~~Joseph M. Gencannon (Builder for Lex. Trust Co.)~~

Service No. ~~55~~ 2273

Address 157 Warren Avenue, Milton, Mass.  
37 Preston Rd.

#3573

Location 37 Preston Road (Opp. #40)

Kind of Pipe

Size

Size of Main

~~Repair - Renewal~~ — New Service

Location

Date	Material	Amount	Total	Date	Amount
1937					
Sept/28	Flat Rate: 62' 1" Copper Tubing @ 50¢		31 00	Sept. 23 1937 Paid	31 00
	62' 1" Cop. Tub. @ 30¢		18 60		
	1 1" S. & W.		3 75		
	1 Box & Rod		2 00		
	2 hrs. trucking @ 75¢		1 50		
			25 85		
	Labor				

Hadley Press, Inc., Lexington

DATE Sept. 22. 1937.

# TOWN OF LEXINGTON—BOARD OF PUBLIC WORKS

## WATER DIVISION

The undersigned applies for a supply of water at No. 37 Preston Rd St. and hereby agrees to comply with the rules and regulations as now, or at any future time, established by the Board of Selectmen.

Am't. of Estimate \$ 31.<sup>00</sup>


Owner Joseph M Concanon

Am't. Paid \$ \_\_\_\_\_

Address 157 Warren Ave  
Milton Mass

Builder \_\_\_\_\_

Sketch of Service Here

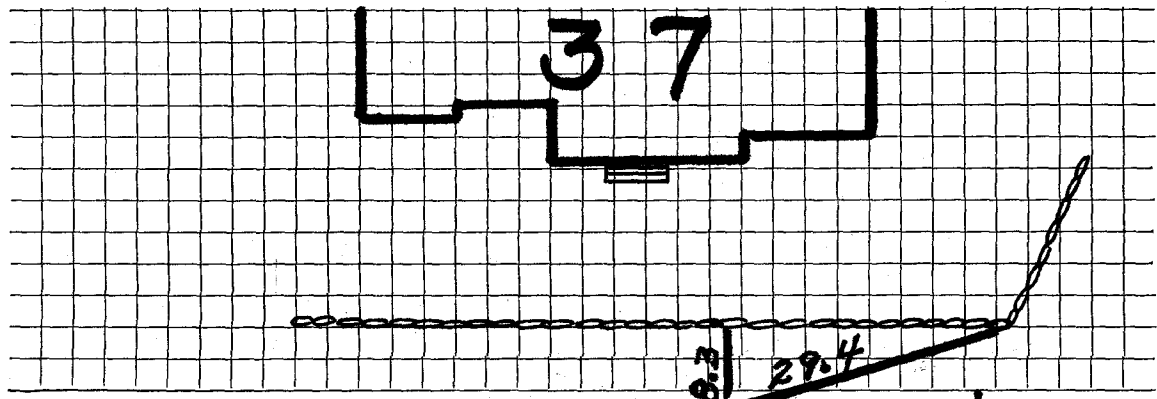

Connection made in \_\_\_\_\_ Street.

Remarks:

Work completed