

WATER SERVICE RECORD

#1557
342#1558

Name **William Welch**

Service No.

Address **39 Preston Road**

Location **Lexington, Mass.**

~~XXXXXX~~ **New Service**


Com. 12-26-50

Date	Material	Amount	Total	Date	Material	Amount
Nov. 25, '50	Labor	2 60	2 60	Nov. 25, '50	Deposited	3000
	10% Overhead		26			
	33' - 3/4" Copper Tubing @.334	11 02			No Charge	199 39
	1 - 3/4" C x 1/2" I.W.H. S&W	3 76		Nov. 25, '50	Labor	2 60
	Littlefield Shovel 2 hrs. @7.00	14 00			18' - 3/4" Copper Tubing @.334	6 01
	Trucking 1 hr. @.75	75			1 - 3/4" C Corp-cock	3 60
	Patching 7 x 3	7 00			1 - 3/4" C x 3/4" C Curb-cock	4 40
			39 39		1 - Box & Rod	3 35
					1 - 1/2" Offset Tail Piece	42
					1 - 1/2" Straight Tail Piece	42
					Littlefield Shovel 2 hrs. @ 7.00	14 00
					Trucking 1 hr. @.75	75
						35 55

DATE _____

TOWN OF LEXINGTON — BOARD OF PUBLIC WORKS
WATER DIVISION

Sketch of Service Here

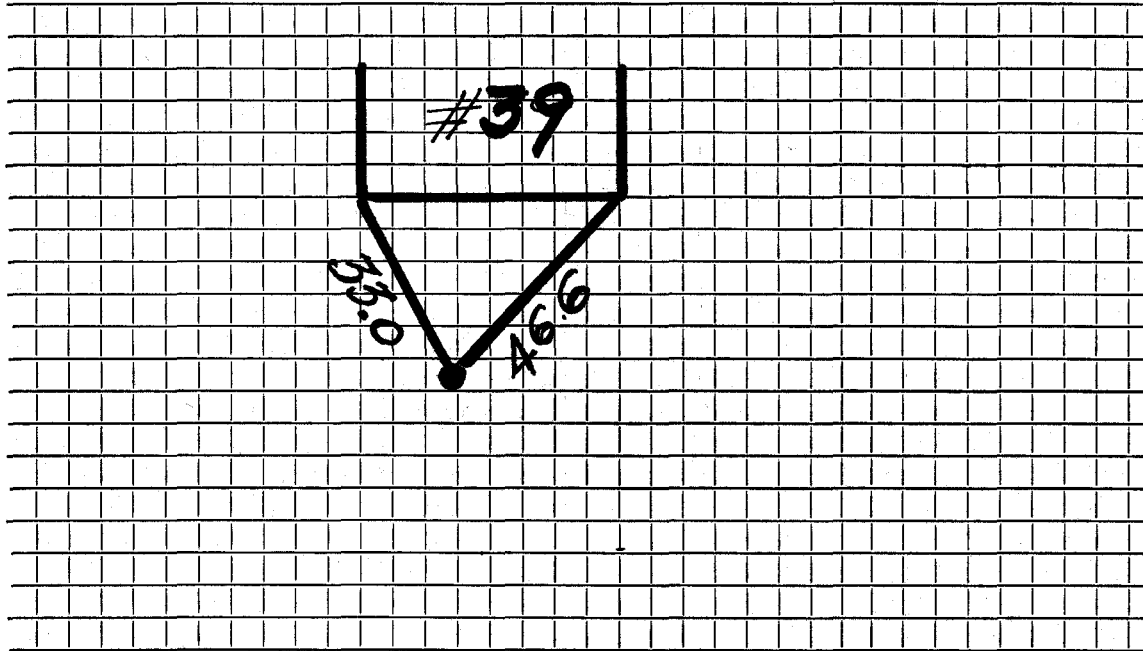

Connection made in Street. Work completed

Remarks:

.....

.....