

Name Lexington Trust Company

Service No. ~~42~~ 2274

Address Lexington, Mass. (James F. Little, Agt.)
40 Preston Rd.

Location 40 Preston Rd.

#3915

Kind of Pipe

Size

Size of Main

~~Repair~~ ~~Renewal~~ - New Service

Location

Date 1937	Material	Amount	Total	Date 1937	Amount
6/18/37	2 hrs. @ 50¢	1 00		July 15. Paid. Billed	49 92
21	" @ 55¢	11 55			
7	" @ 60¢	4 20	16 75		
	10% Overhead		1 67		
	46' 3/4" Cop. Tubing @ 25¢		11 50		
	1 3/4" Curb Cock		3 25		
	1 3/4" Lead corp. cock.		4 00		
	1 3/4" Adapter		5 75		
	1 3/4" S. & W.		3 75		
	1 Box & Rod		1 75		
	2 hrs. trucking @ 75¢		1 50		
			<u>\$49 92</u>		
	Labor				

DATE June 10th 1937

TOWN OF LEXINGTON—BOARD OF PUBLIC WORKS

WATER DIVISION

The undersigned applies for a supply of water at No. 40 Preston Rd. St. and hereby agrees to comply with the rules and regulations as now, or at any future time, established by the Board of Selectmen.

Am't. of Estimate \$ _____

Owner Lexington Trust Co


Am't. Paid \$ _____

Address Lexington

Builder Joseph W Concaum Co

Mass
James F Latta agent

Sketch of Service Here

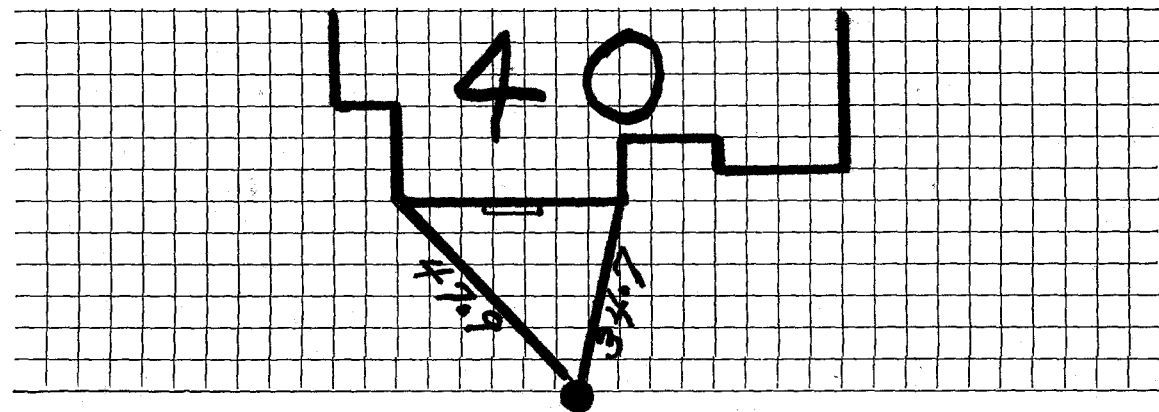

Connection made in _____ Street.

Work completed _____ 19

Remarks: