

Name Whitten Brothers

Service No. 253

Address 41 Preston Road

6736

Lexington, Mass.

Location 41 Preston Road

Kind of Pipe

Size

Size of Main

New Service

Com. 12-13-49

Location

Date	Material	Amount	Total	Date	Amount
Dec. 2, '49	Labor	2 35	2 35	Nov. 23 '49	20 00
	10% Overhead		24	12-7-54	20 51
	37' 3/4" Copper Tubing @ .24	8 88			40 51
	1 - 3/4" C x 1/2" I.W.H. S&W	3 29		Dec. 2, '49	2 35
	Trucking 1 hr. @ .75	75		45' - 3/4" Copper Tubing @ .24	10 80
	Patching 25 x 3	25 00		1 - 3/4" C Corp-cock	3 15
		40 51		1 - 3/4" C x 3/4" C Curb-cock	3 85
				1 - Box & Rod	3 75
				1 - 1/2" Straight Tail Piece	37
				1 - 1/2" Offset Tail Piece	37
				Littlefield Shovel 3 1/2 hrs. @ 7.00	24 50
				Trucking 1 hr. @ .75	75
	Labor				49 89

Bill sent 12-22-49
 Bill sent 12-7-52

Deposited
 Paid

No Charge

DATE _____

TOWN OF LEXINGTON – BOARD OF PUBLIC WORKS
WATER DIVISION

The undersigned applies for a supply of water at No..... St. and hereby agrees to comply with the rules and regulations as now, or at any future time, established by the Board of Selectmen.

Am't of Estimate \$.....

Owner


Am't Paid \$.....

Address

Builder

.....

Sketch of Service Here

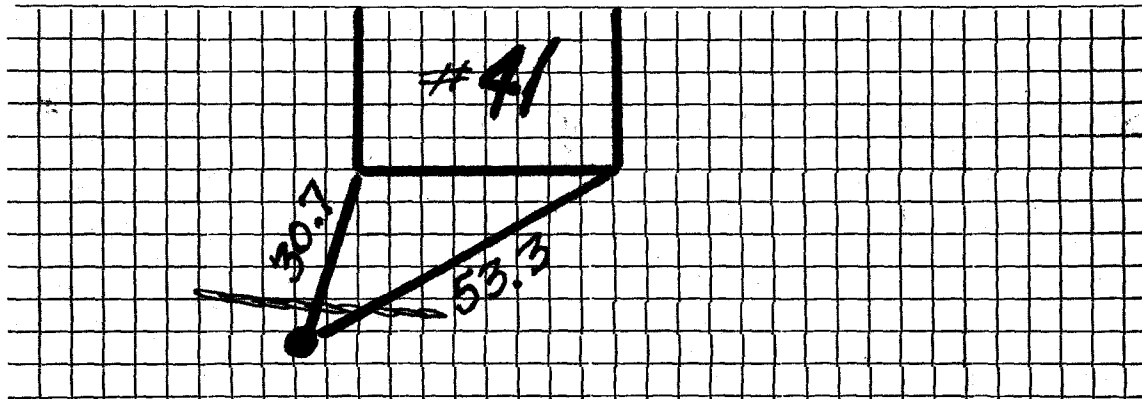

Connection made in Street.

Work completed19

Remarks: