

WATER SERVICE RECORD

#797

Name **Edwin S. Johnston**

Service No. 208

Address **6 Preston Road**

#687

Location **Lexington, Mass.**

~~REPAIR OVERHEAD~~ New Service


Cam 11-13-51

Date	Material	Amount	Total	Date	Amount
9/27/51	Labor	1 49	1 49	8-29-51	25 00
	10% overhead		15	11-13-51	3 55
	40' - 3/4" copper tubing@.326	13 04	13 04		<u>NON CHARGE</u>
	1 -3/4" C x 1/2 I.W.H. stop&waste		4 00	9/27/51	Labor
	1 -3/4" Cx3/4" C.union(3pts.)		1 72		8' -3/4" copper tubing@.326
	1 hr. trucking		75		1 -3/4" C. corp-cock
			21 15		1 -3/4" Cx3/4" C.curb-cock
					1 - bdx and rod
					1 - 1/2 straight tail piece
					1 - 1/2 offset tail piece
					1 hr. trucking
					<u>75</u>
					19 52

DATE _____

TOWN OF LEXINGTON — BOARD OF PUBLIC WORKS
WATER DIVISION

Sketch of Service Here

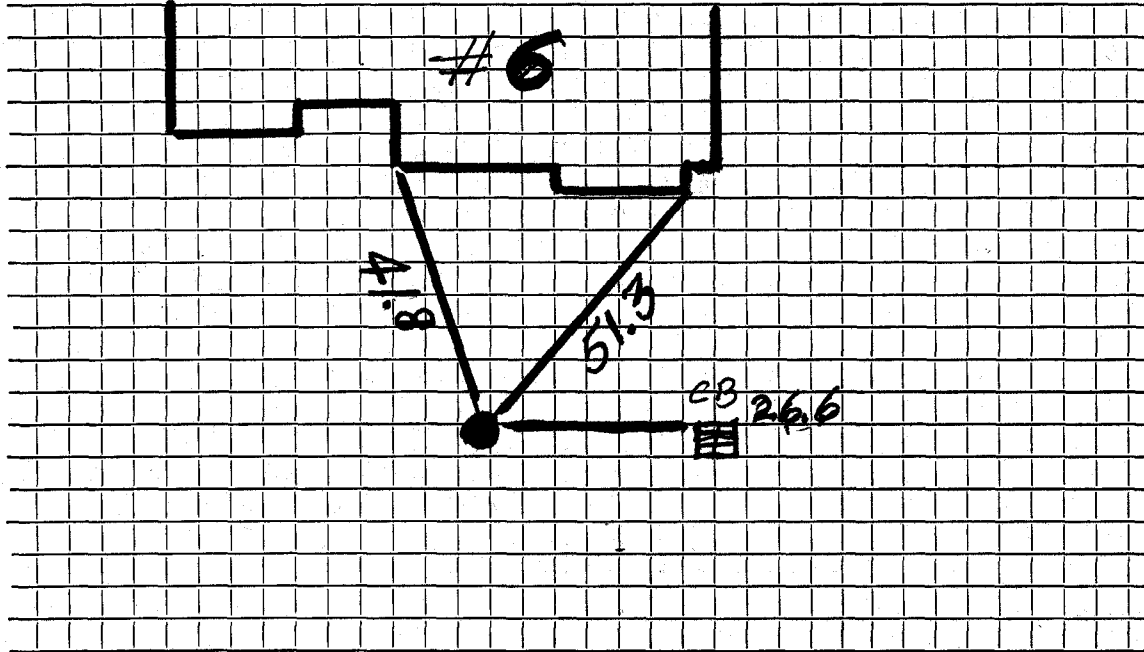

Connection made in Street. Work completed

Remarks:

.....

.....