

## WATER SERVICE RECORD

2325  
Service No.

Name

Address ~~7 Preston Road~~ 7 Preston Road

Location

Repair—Renewal—New Service (outside) W.O. # 7845


Date	Material	Amount	Total	Date	Amount
	32' 1" Pipe				
	2 1" ELLs				
	1 1" Space Nipple				
	1 Stop + Waste			6/9/70	
					<u>OUTSIDE</u>
					Labor 63.12
					" 43.38
					" 32.23
					34' 3/4" copper pipe at.79
					1 3/4" curb cock
					1 1" lead-lined coupling
					1 3/4" adaptor
					1/2 ton cold @ 5.85
					6 hrs. trucking @ 3.00
					5 hrs. shovel @ 4.00
					1 hrs roller @ 3.00
					1 hr. trailer @ 2.00
					<u>\$ 226.20</u>

DATE \_\_\_\_\_

TOWN OF LEXINGTON — BOARD OF PUBLIC WORKS

**WATER DIVISION**

Sketch of Service Here

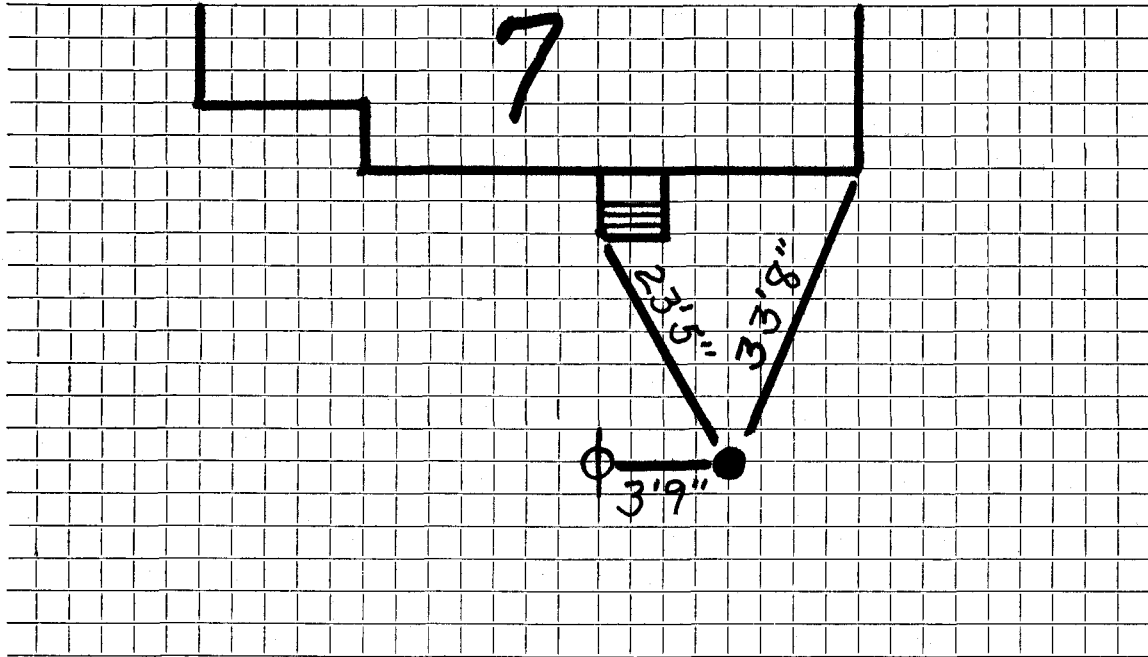

Connection made in ..... Street. Work completed .....

Remarks: .....  
.....  
.....