

Name Roy Homes, Inc.

Service No. ~~117~~ 2271

Address Central Building, Cambridge, Mass.

2891

9 Preston Rd.

Location 9 Preston Road

Kind of Pipe

Size

Size of Main

Repair—Renewal—New Service

Location

Date
1941

Material

Amount

Total

Date

Amount

Nov. 8,

6 hrs. @ 60¢

3 60

October 16, 1941 Deposited

14 00

Com 12/21/41

10% Overhead

36

34' 3/4" Copper tubing @ 19¢

6 46

1 3/4" C.x1/2" I.S.& W.

2 50

1 hr. trucking @

75

13 67

(CHARGE 14.00)

Labor

Hadley Press, Inc., Lexington

DATE _____

TOWN OF LEXINGTON—BOARD OF PUBLIC WORKS

WATER DIVISION

(Lots 37,38,39

The undersigned applies for a supply of water at No. 9 Preston Road St. and hereby agrees to comply with the rules and regulations as now, or at any future time, established by the Board of Selectmen.

Am't. of Estimate \$ 35.00 Town
 14.00 Owner


Owner Clarence Cerepps

Am't. Paid \$ _____

Address _____

Builder _____

Sketch of Service Here

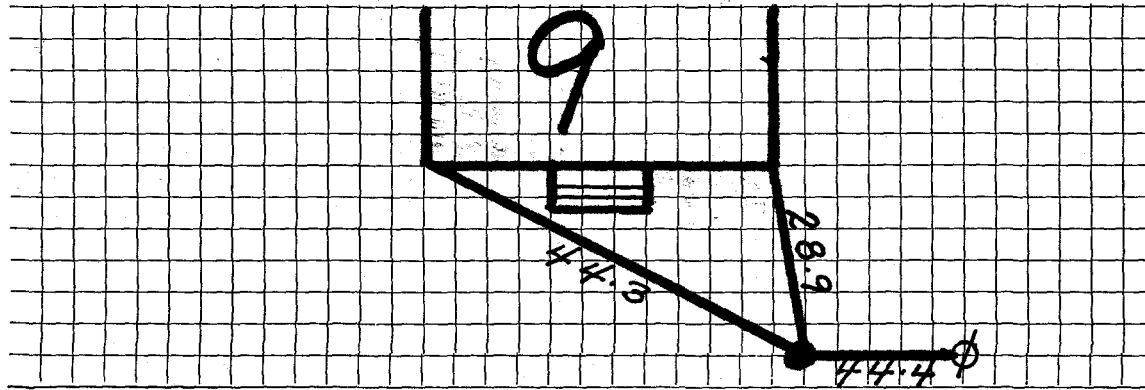

Connection made in _____ Street. Work completed _____ 19

Remarks: