

WATER SERVICE RECORD

#4840

Name Joseph Chisholm

Service No. 22

Address 11 Prospect Hill Rd.

Location

~~Repair/Replacement~~ New Service

Com. 4-11-55

Date	Material	Amount	Total	Date	Amount
3/8/55	Labor	1 85		2-23-55	Deposited 40 00
	10% overhead	19	2 04	4-11-55	*Refunded 17 81
	44' - 3/4" copper tubing @ .35		15 40		<u>NON CHARGE</u> 22 19
	1 - 3/4" C x 1/2 I.W.H. stop & waste		4 00	3/8/55	Labor 1 85
	1 hr. trucking		75	3/9/55	" 20 30
			22 19	24' - 3/4" copper tubing @ .35	8 40
				1 - 3/4" C. corp-cock	4 33
				1 - 3/4" C. curb-cock	4 67
				1 box and rod	3 90
				1 - 1/2 straight tail pc.	50
				1 - 1/2 offset tail pc.	50
				2 hrs. town shovel @ 5.00	10 00
				1 hr. trucking	75
					55 20


**Refund made payable to town to apply on bal. due on S.A.C. #6*

DATE _____

TOWN OF LEXINGTON — BOARD OF PUBLIC WORKS

WATER DIVISION

Sketch of Service Here

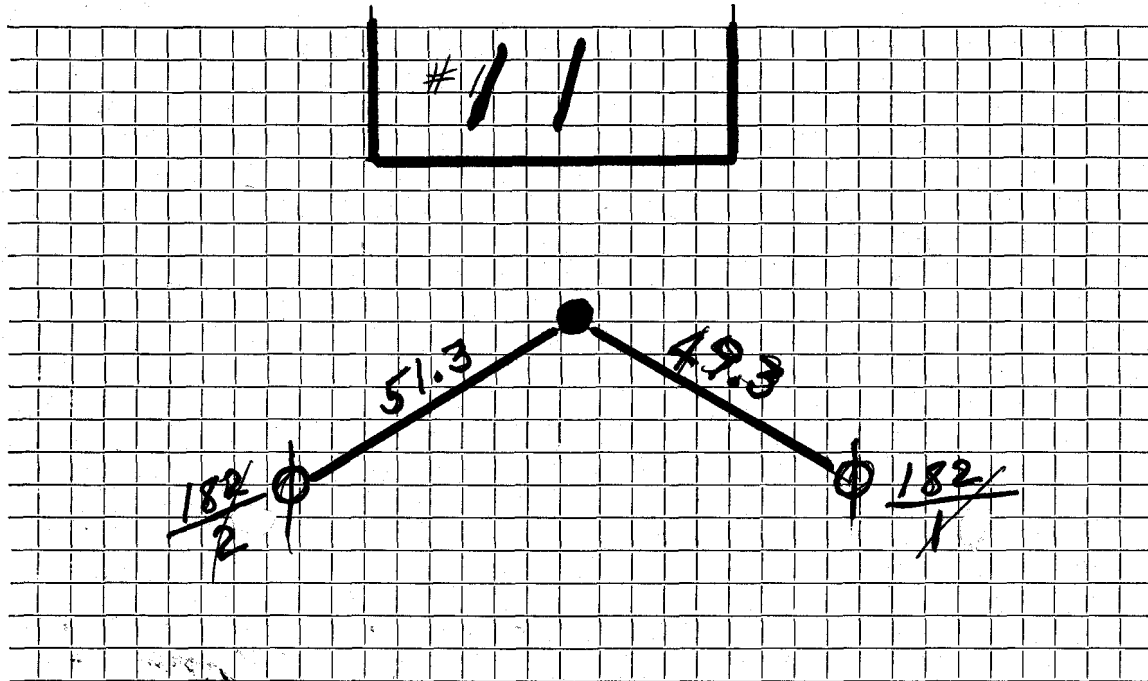

Connection made in Street. Work completed

Remarks:

.....

.....