

WATER SERVICE RECORD

Name Barbara Romanik

Service No. 64

Address 15 Prospect Hill Road

Location

~~Repair~~—Renewal—~~New Service~~ W. O. # 133

FEB 12 1973


Date		Material	Amount		Total		Date	Amount	
10/3/72		Labor	93	11			9/29/72	Deposit	300 00
10/13/72		"	16	33			2/12/73	Refund	82 75
		10% O.H.	10	94	120	34			217 25
	60'	3/4" Copper pipe .79			47	40	8-7-51		
		3/4"x3/4" Stop & Waste			12	01		24' 3/4" Copper	
	1/2	Yd. loam 3.50			1	75		1 3/4" C. Adapter	
	1 1/2	Ton hot top 8.00			12	00		1 3/4" C. X 3/4" C. Curb Cock	
	2	Hrs. shovel 6.50			13	00		1 Box + Rod	
	2	Hrs. Trucking 3.00			6	00			
	1/2	" " 1.50				75			
		Roller			2	00			
		Trailer			2	00			
					217	25			

DATE _____

TOWN OF LEXINGTON — BOARD OF PUBLIC WORKS

WATER DIVISION

Sketch of Service Here

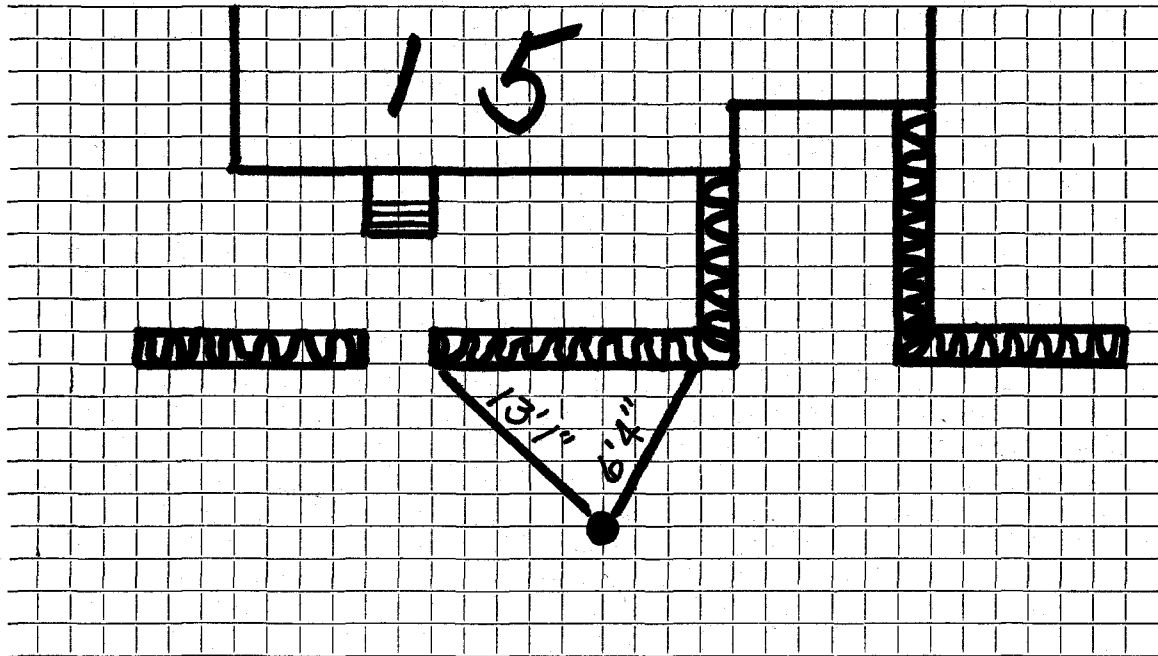

Connection made in Street. Work completed

Remarks:
.....
.....