

Name C. A. Huntington

1346

Service No. ~~22~~ 2277

Address 34 Silk St., Arlington
18 Prospect Hill Rd.

#18

Location Lot #57, Prospect Hill Road

Kind of Pipe

Size

Size of Main

~~Repair~~ ~~Renewal~~ - New Service

Location

Date	Material	Amount	Total	Date	Amount
Comm. 30.- 10-18-32	40' 1" C.I. Pipe @ .27	10 80			
	2 1" L.L. Coup. @ .25	50			
	2 1" Br. Sp. Nip. @ .20	40			
	2 1" L.L. Ells @ .30	60			
	1 S & W	3 00			
	Trucking	75	\$16 05		
9/8/32	7 Hrs. Labor @ .55	3 85			
	3 " " @ .60	1 80	5 65		
	15% Overhead		85		
	COST		22 55		
CHARGE	40' @ .75	\$30 00	\$30 00		
	Labor				

Sept. 13 1932 - Cash

6/7/00
39' INSIDE
GREGORIO & SON'S
1" COPPER
1" FX 1" COMP

30 -

Lexington
Hadley Press, Inc.

Owner do digging + backfilling

DATE August 23, 1932

TOWN OF LEXINGTON—BOARD OF PUBLIC WORKS

WATER DIVISION

The undersigned applies for a supply of water at No. ^{#18} Lot #57 Prospect Hill St. and hereby agrees to comply with the rules and regulations as now, or at any future time, established by the Board of Selectmen.

Am't. of Estimate \$ _____

Owner

C. A. Huntington

Am't. Paid \$ _____


Address

34 Silk St.

Builder _____

Arlington Mass.

Sketch of Service Here

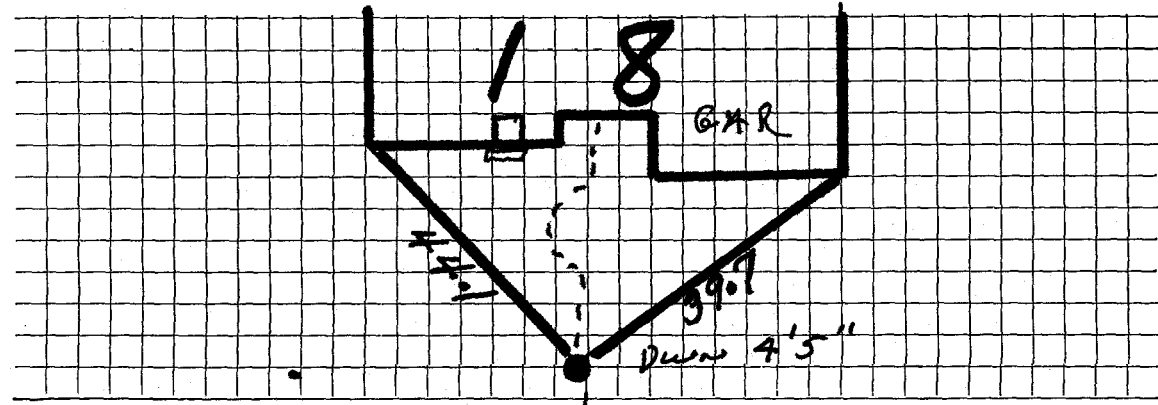

Connection made in _____

Street.

Work completed _____ 19

Remarks:

LEAD