


TOWN OF LEXINGTON — BOARD OF PUBLIC WORKS

WATER DIVISION

Sketch of Service Here

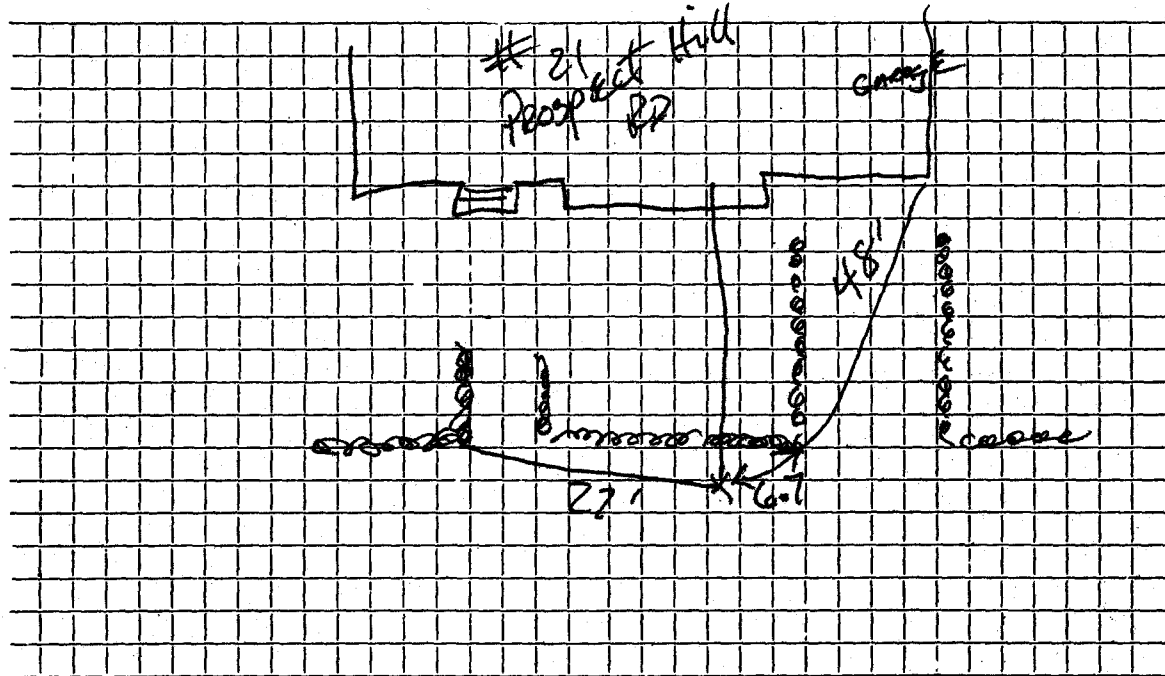

Connection made in Street. Work completed

Remarks: Curb is just over 3' deep - had contractor install copper under wall - gas service 18" to right of water facing the house