

Name F. J. Peterson

Service No. 188

Address 22 Prospect Hill Road

Lexington, Mass.

Location 22 Prospect Hill Road

Kind of Pipe

Size

Size of Main

~~Repair-Renewal~~—New Service

Com. 11-6-50

Location

Date	Material	Amount	Total	Date	Location	Amount
Aug. 5, '50	Labor	5 10	5 10	July 27 '50	Deposited	50 00
	10% Overhead		51			
	47' - 3/4" Copper Tubing @.23		10 81		No Charge	43 85
	1 - 3/4"C x 1/2" I.W.H. S&W		3 29	Aug. 7, '50	Labor	15 30
	1 - 3/4"C x 3/4"C Union (3pts)		1 39	14' - 3/4" Copper Tubing @.23		3 22
	Littlefield Shovel 2 hrs. @7.00		14 00	1 - 3/4"C Corp-cock		3 15
	Trucking 1 hr. @.75		75	1 - 3/4"C x 3/4"C Curb-cock		3 85
	Patching 8 x 3		8 00	1 - Box & Rod		3 35
			43 85	1 - 1/2" Offset Tail Piece		42
				1 - 1/2" Straight Tail Piece		42
				Littlefield Shovel 2 hrs. @ 7.00		14 00
				trucking 1 hr. @ .75		75
	Labor					44 46

Hadley Press, Inc., Lexington

DATE \_\_\_\_\_

# TOWN OF LEXINGTON—BOARD OF PUBLIC WORKS

## WATER DIVISION

The undersigned applies for a supply of water at No. \_\_\_\_\_ St. and hereby agrees to comply with the rules and regulations as now, or at any future time, established by the Board of Selectmen.

Am't. of Estimate \$ \_\_\_\_\_


Owner \_\_\_\_\_

Am't. Paid \$ \_\_\_\_\_

Address \_\_\_\_\_

Builder \_\_\_\_\_

Sketch of Service Here

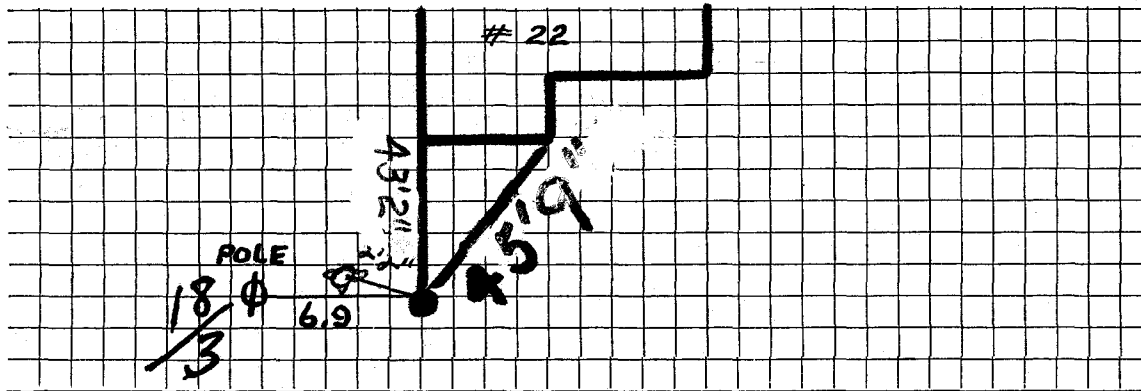

Connection made in \_\_\_\_\_ Street.

Work completed \_\_\_\_\_ 19

Remarks: