

Name

Service No.

104 571

Address 25 Prospect Hill Road

# 7719

Lexington, Mass.

Location 25 Prospect Hill Road

Kind of Pipe

Size

Size of Main

~~RENEWAL~~—New Service

Location

Date	Material	Amount	Total	Date	Amount
Aug. 7, '48	Labor	4 60	4 60	July 14 '48	Deposited 25 00
	10% Overhead		46	Oct. 28 '48	Refunded 17 80
	48' - 3/4" Copper Tubing @ .255	12 24			Non-Charge 57 20
	1 - 3/4" C x 3/4" I.W.H. S & W	3 15		Aug. 7, '48	Labor 4 60
	Littlefield Shovel 2 hrs. @ 7.00	14 00			20' - 3/4" Copper Tubing @ .255 5 10
	Loader 2 hrs. @ 3.00	6 00			1 - 3/4" C Corp-cock 3 00
	Trucking 1 hr. @ .75	75			1 - 3/4" C x 3/4" C Curb-cock 3 68
	Patching 16 x 3		16 00		1 - Box & Rod 3 55
			57 20		1 - 3/4" Offset Tail Piece 30
					1 - 3/4" Straight Tail Piece 30
					Littlefield Shovel 1 hr. @ 7.00 7 00
					Trucking 1 hr. @ .75 75
	Labor				28 28

Com. 10/25/48

DATE \_\_\_\_\_

TOWN OF LEXINGTON - BOARD OF PUBLIC WORKS

**WATER DIVISION**

The undersigned applies for a supply of water at No..... St. and hereby agrees to comply with the rules and regulations as now, or at any future time, established by the Board of Selectmen.

Am't of Estimate \$.....

Owner .....


Am't Paid \$.....

Address .....

Builder .....

.....

Sketch of Service Here

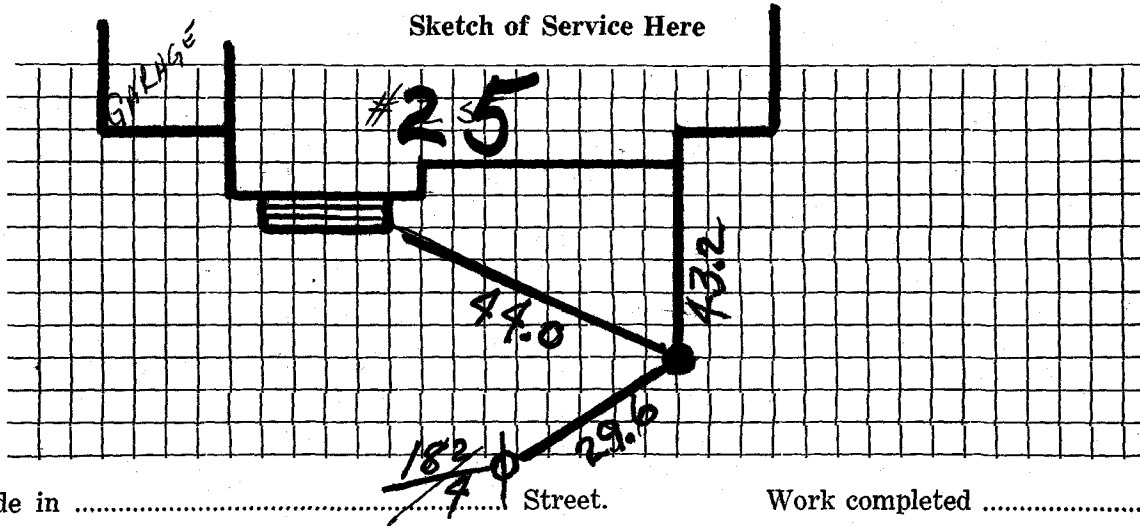

Connection made in ..... Street.

Work completed .....19

Remarks: