

## WATER SERVICE RECORD

# 4159

Name Edward W. Wagner

Service No.

63

Address 30 Prospect Hill Road

Location

Repair \* Renewal \* New Service \* #7509

JAN 27 1969


Date	Material	Amount	Total	Date	Amount
10/16/68	Labor	59 00		10-11-68	500 00
10/17/68	"	22 04		1-27-69	384 40
	10% O.H.	8 10	89 14		315 00
92'	3/4" Copperpipe .79		72 68	10/16 68	Labor 46 42
	3/4" Stop & Waste		11 13	12'	Coppertubing . 79 9 48
	3/4" 3 Part Union		3 05		3/4" Corporation 9 57
1	Ground Clamp		50		3/4" Curb Cock 11 32
5	Yds Loam @ 3.50		17 50		Box & Rod 5 10
1	Lb. Seed		1 10	1	Yd. Loam 3 50
2	Hrs. Shovel @ 6.50		13 00	2	Hrs. Shovel @ 6.50 13 00
3	" Trucking @ 1.50		4 50		98 39
1	" "		3 00		
			215 60		

DATE \_\_\_\_\_

TOWN OF LEXINGTON — BOARD OF PUBLIC WORKS

**WATER DIVISION**

Sketch of Service Here

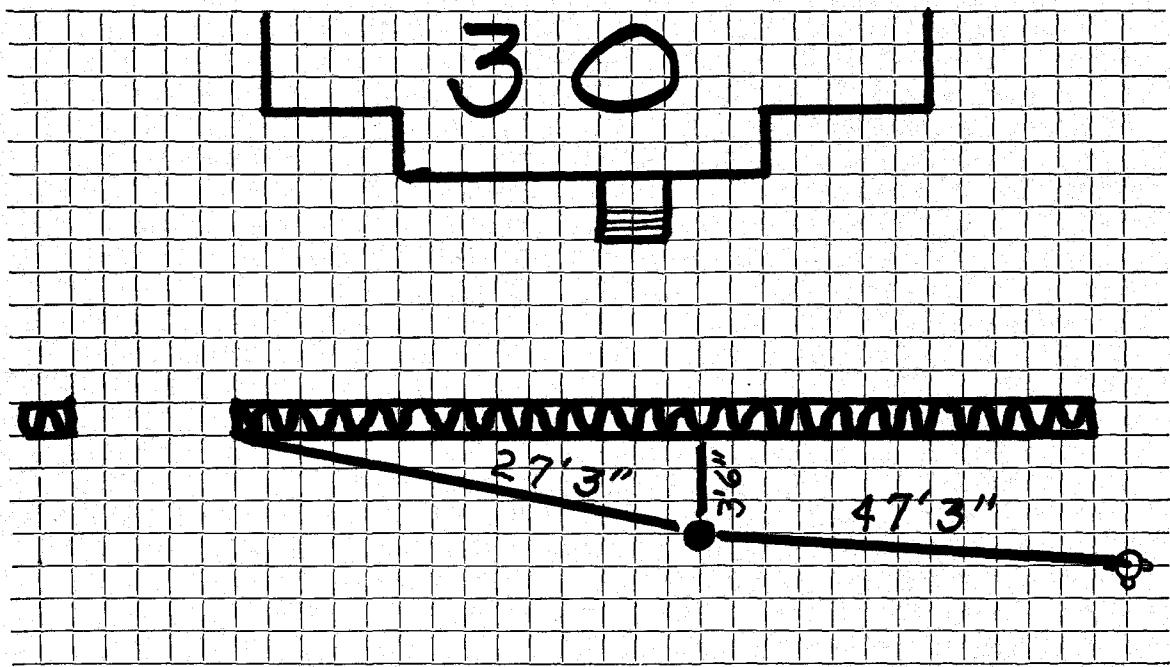

Connection made in ..... Street. Work completed .....

Remarks: .....  
.....  
.....