

WATER SERVICE RECORD

Name Donald Hodgkins

Service No. 16

Address 33 Prospect Hill Road

1795

Location

~~REPAIR~~—Renewal—~~NEW SERVICE~~

W.O. #6286

JUL 7 1969


Date	Material	Amount	Total	Date	Amount
5/15/69	Labor	39 60		5-8-69	150 00
5/17/69	"	9 87		8-18-69	8 41
6/2/69	"	21 24			158 41
	10% O.H.	7 71	78 42		NON CHARGE
47	3/4" Copperpipe @ 79		34 89	3-4-61	Labor 98. 73
1	3/4" Wheel Valve		9 30	19	3/4" Copper tubing @.42 7.98
3	Yds. Loam @ 3.50		10 50	1	3/4" C Gurb Cock 6.28
3	Lbs. Grass seed @ 1.10		3 30	1	1" Style 38 Coupling 3.43
3	Hrs. Trucking @ 3.00		9 00	1	1" Lead Lined Coupling .54
2	Hrs. Shovel @ 6.50		13 00	1	1" x 6" Cement Lined Nipple .53
			158 41	16	x 3 Patch 16.00
				4	hrs. Pippin Shovel @5.00 20.00
				2	hrs. Trucking @3.00 6.00
					159.49

Bill sent 8.41

DATE _____

TOWN OF LEXINGTON — BOARD OF PUBLIC WORKS
WATER DIVISION

Sketch of Service Here

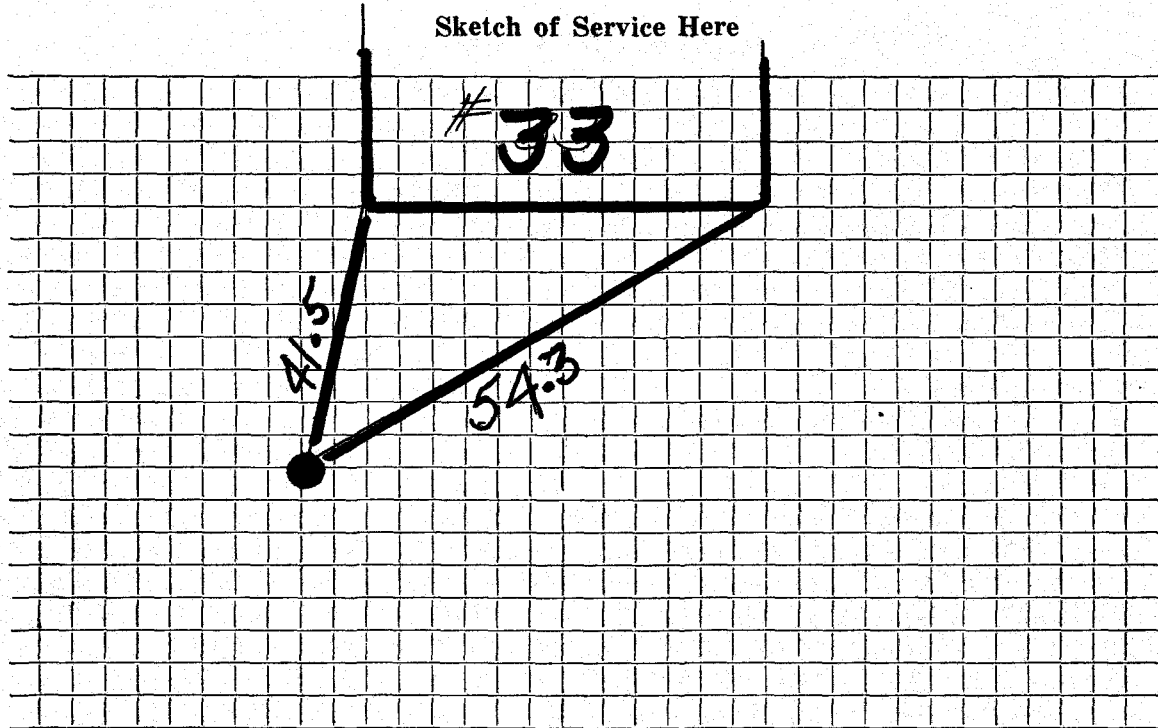

Connection made in Street. Work completed

Remarks: *Original Service 7-25-27*

.....
.....